




SEE MAP 3

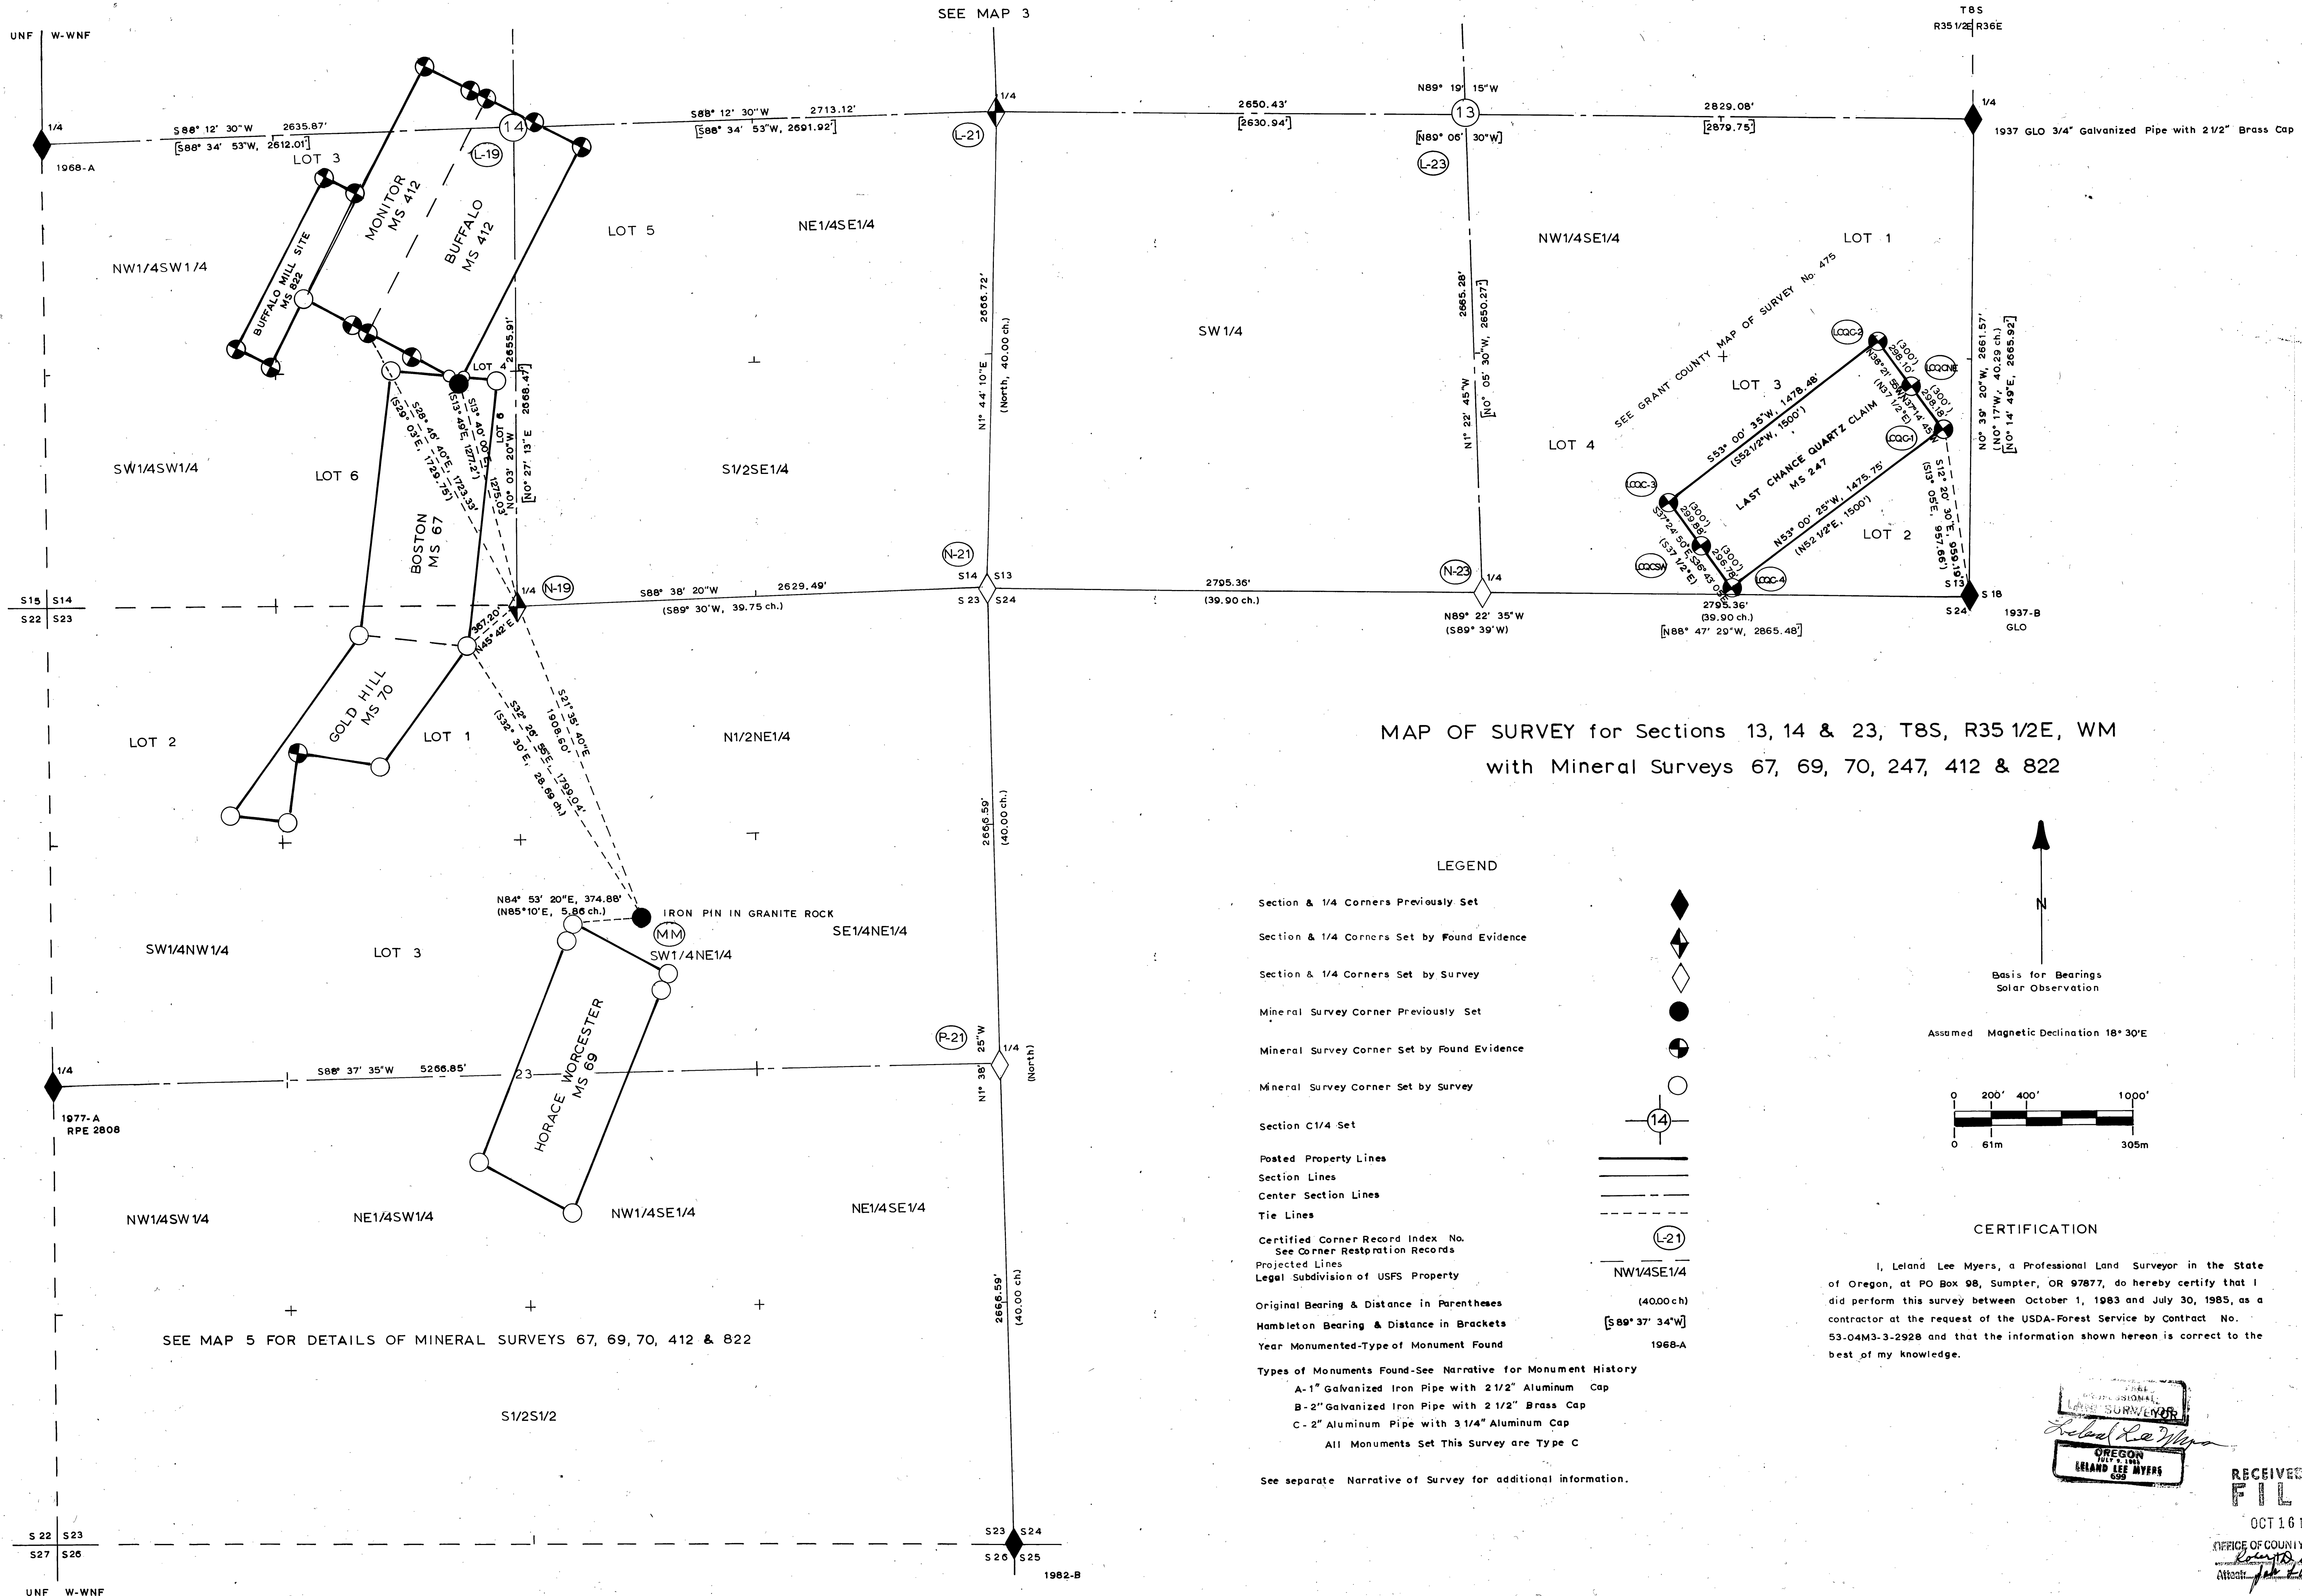

MAP OF SURVEY for Sections 13, 14 & 23, T8S, R35 1/2E, WM
with Mineral Surveys 67, 69, 70, 247, 412 & 822


LEGEND

- Section & 1/4 Corners Previously Set
- Section & 1/4 Corners Set by Found Evidence
- Section & 1/4 Corners Set by Survey
- Mineral Survey Corner Previously Set
- Mineral Survey Corner Set by Found Evidence
- Mineral Survey Corner Set by Survey
- Section C1/4 Set
- Posted Property Lines
- Section Lines
- Center Section Lines
- Tie Lines
- Certified Corner Record Index No.
See Corner Restoration Records
- Projected Lines
- Legal Subdivision of USFS Property
- Original Bearing & Distance in Parentheses
- Hambleton Bearing & Distance in Brackets
- Year Monumented-Type of Monument Found
- Types of Monuments Found-See Narrative for Monument History
- A-1" Galvanized Iron Pipe with 2 1/2" Aluminum Cap
- B-2" Galvanized Iron Pipe with 2 1/2" Brass Cap
- C-2" Aluminum Pipe with 3 1/4" Aluminum Cap
- All Monuments Set This Survey are Type C
- See separate Narrative of Survey for additional information.

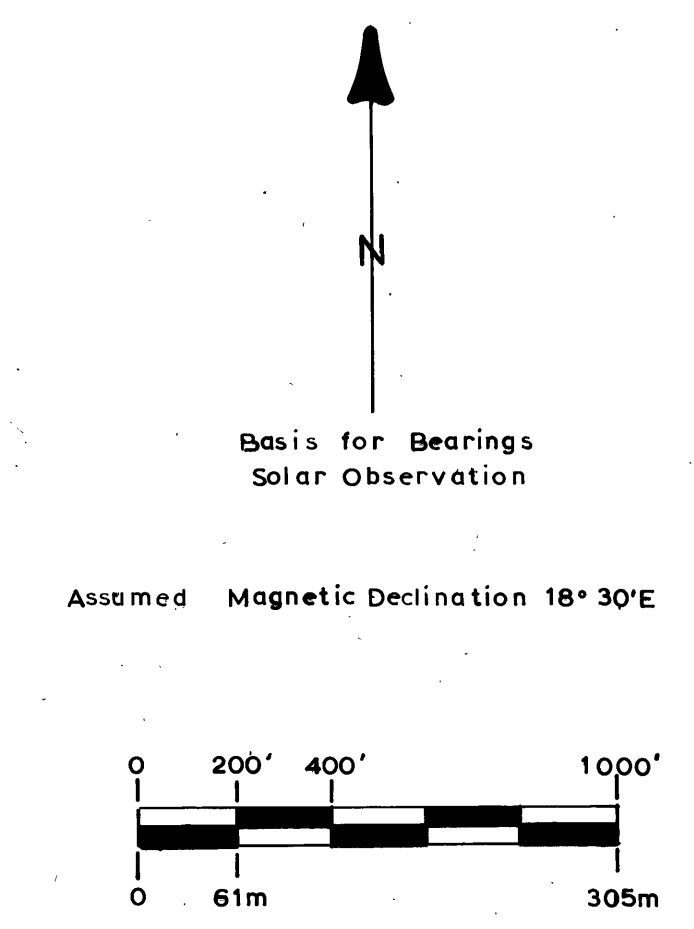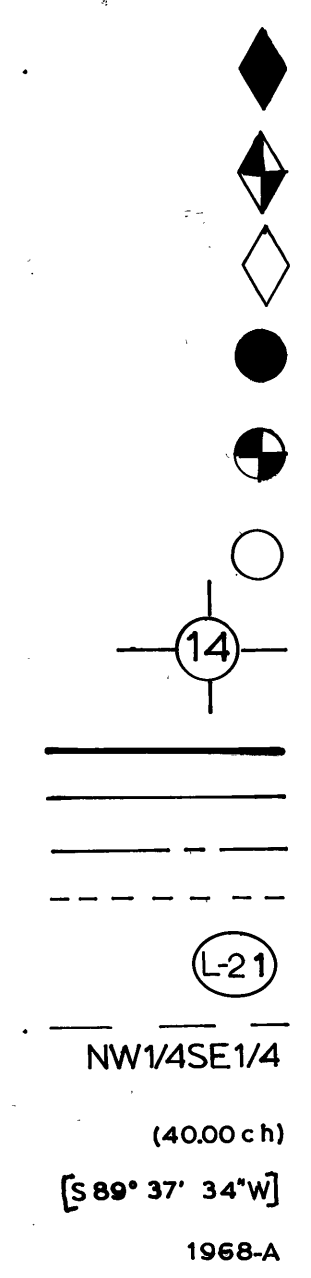

CERTIFICATION

I, Leland Lee Myers, a Professional Land Surveyor in the State of Oregon, at PO Box 98, Sumpter, OR 97777, do hereby certify that I did perform this survey between October 1, 1983 and July 30, 1985, as a contractor at the request of the USDA-Forest Service by Contract No. 53-04M3-3-2928 and that the information shown hereon is correct to the best of my knowledge.

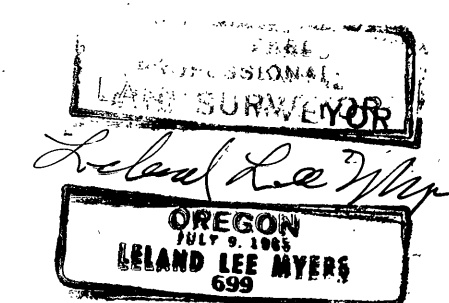

RECEIVED AND
FILED
OCT 16 1985
OFFICE OF COUNTY SURVEYOR
Leland Lee Myers