


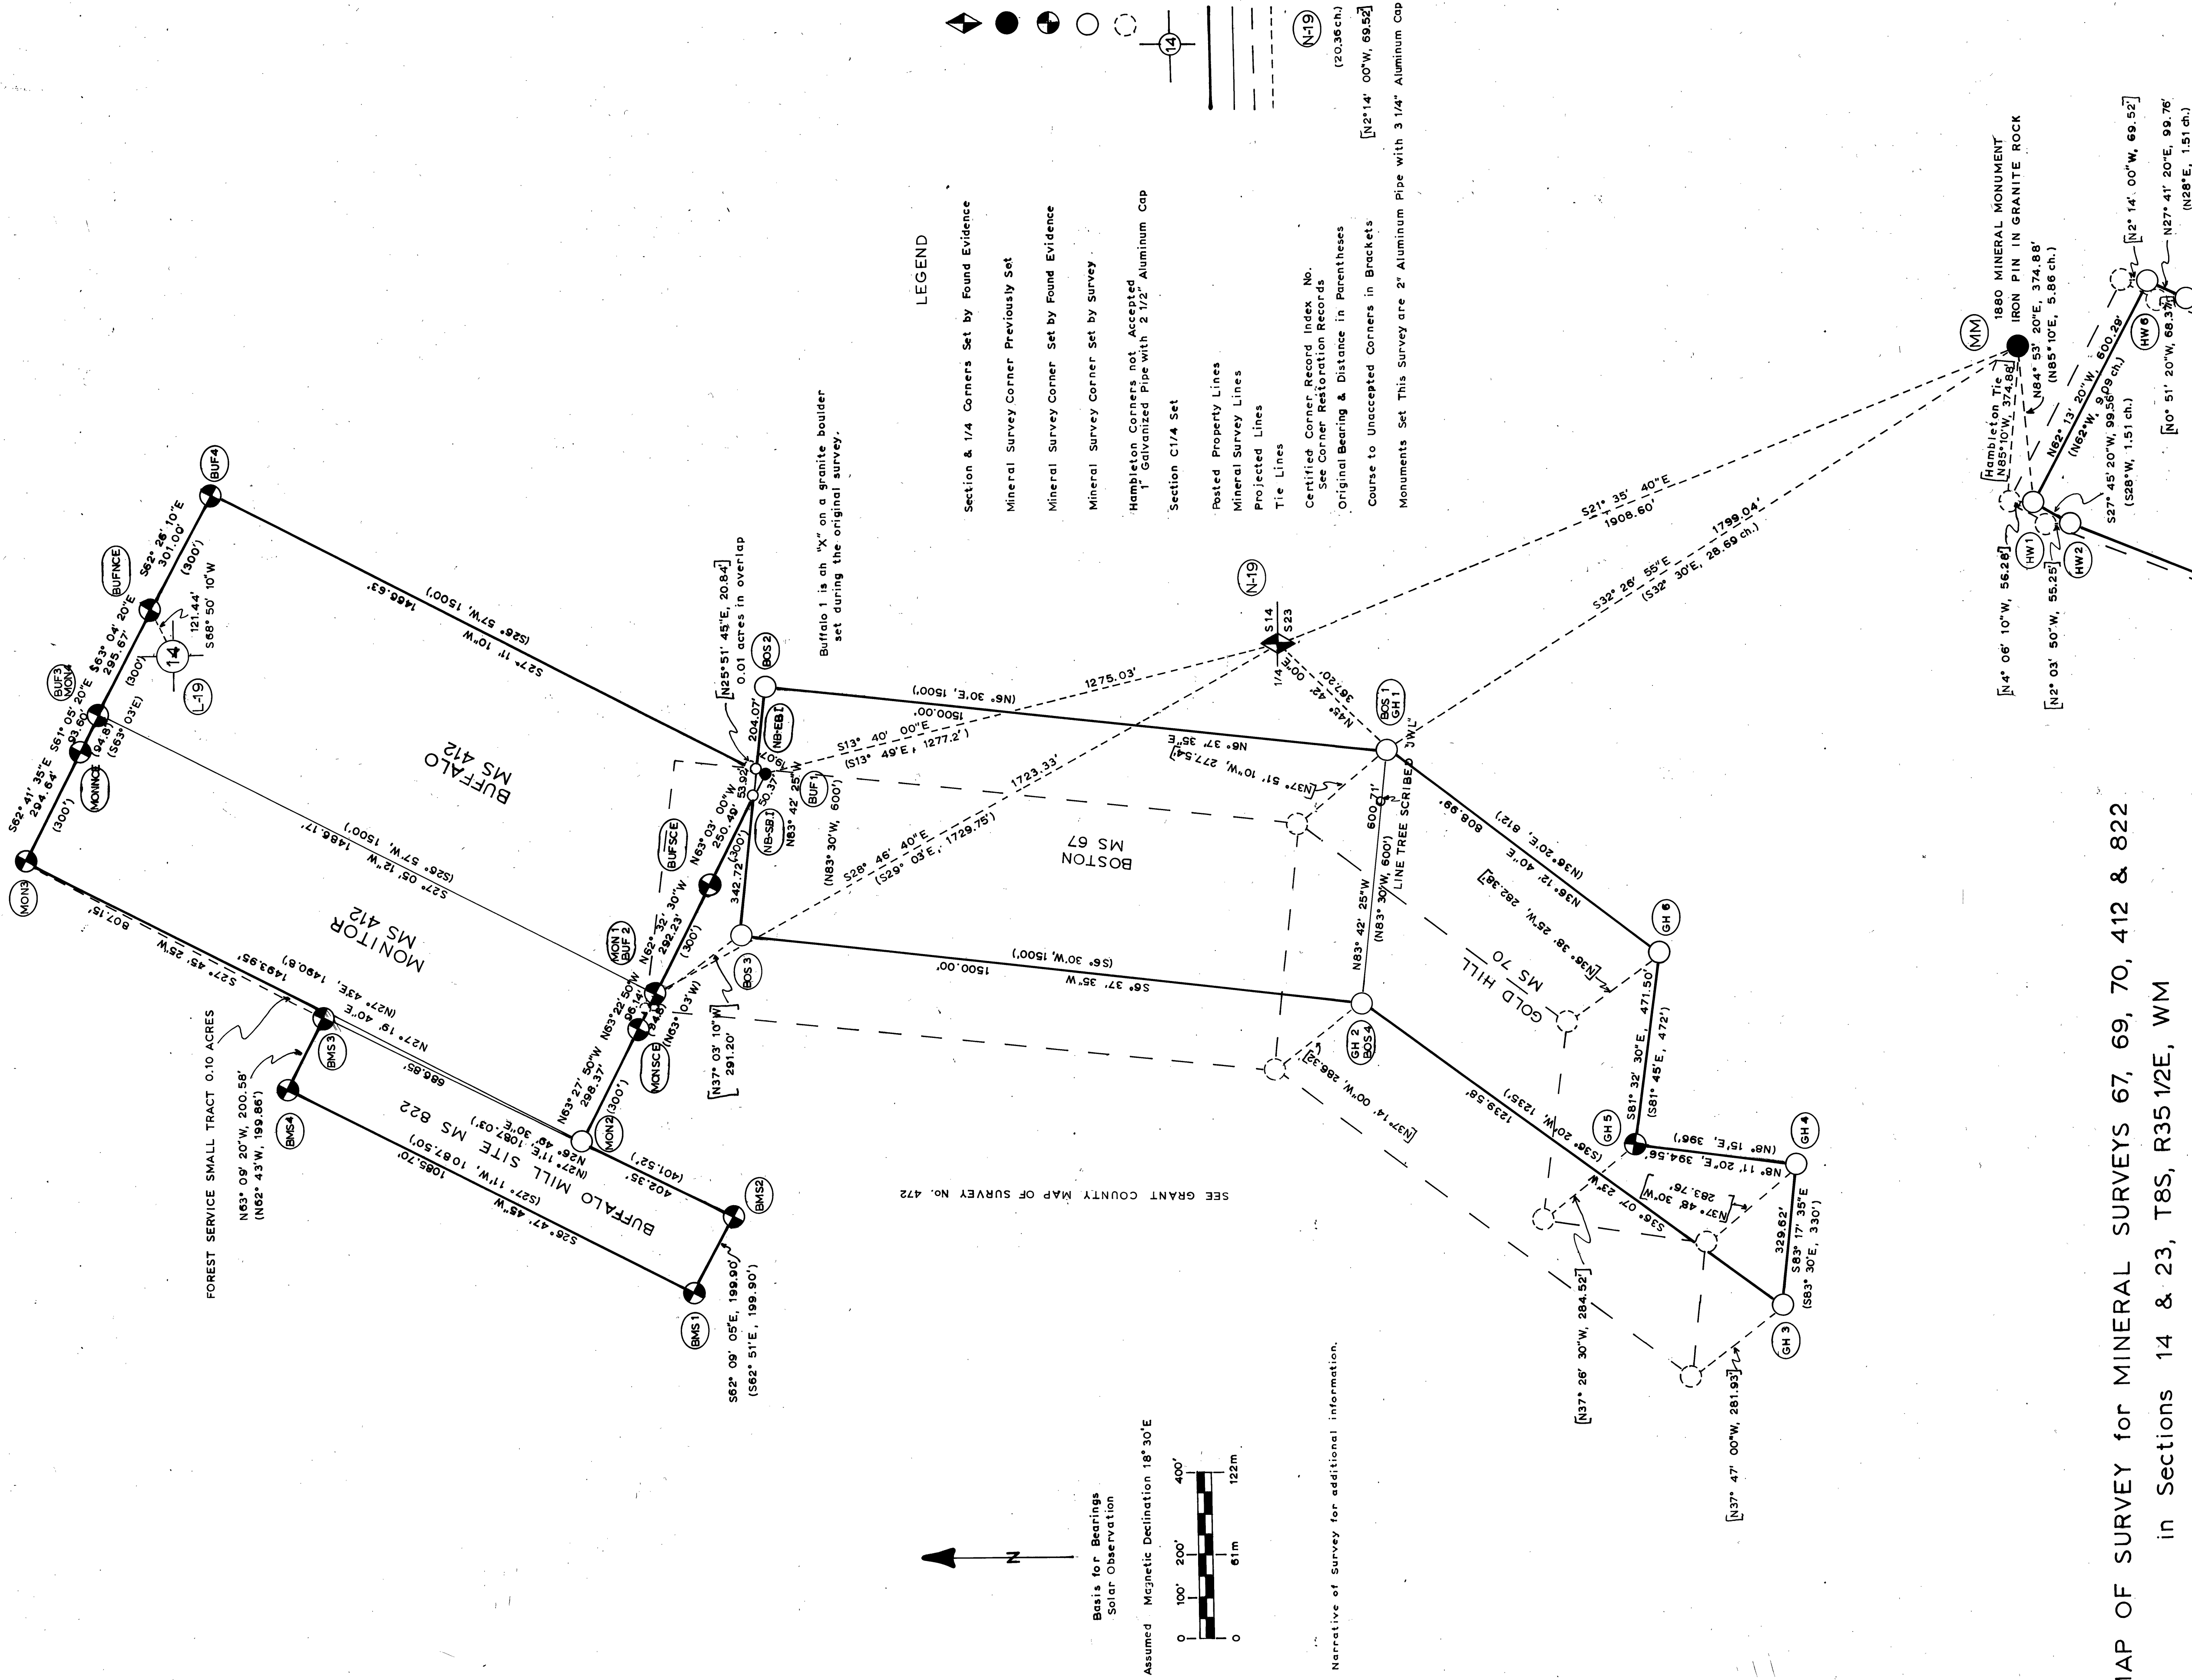

MAP OF SURVEY FOR MINERAL SURVEYS 67, 69, 70, 412 & 822
in Sections 14 & 23, T8S, R35 1/2E, WM
(DETAIL FOR MAP 4)

CERTIFICATION

I, Leland Lee Myers, a Professional Land Surveyor in the State of Oregon, at PO Box 96, Sumpter, OR 97077, do hereby certify that I did perform this survey between October 1, 1983 and July 30, 1985, as a contractor at the request of the USDA Forest Service by Contract No. 53-04M3-3-2028 and that the information shown hereon is correct to the best of my knowledge.

REGISTERED
PROFESSIONAL
LAND SURVEYOR
Leland Lee Myers
OREGON
LELAND LEE MYERS

RECEIVED AND
FILED
OCT 16 1985
OFFICE OF COUNTY SURVEYOR
Robert M. Baxley
Attest: *John L. White*