

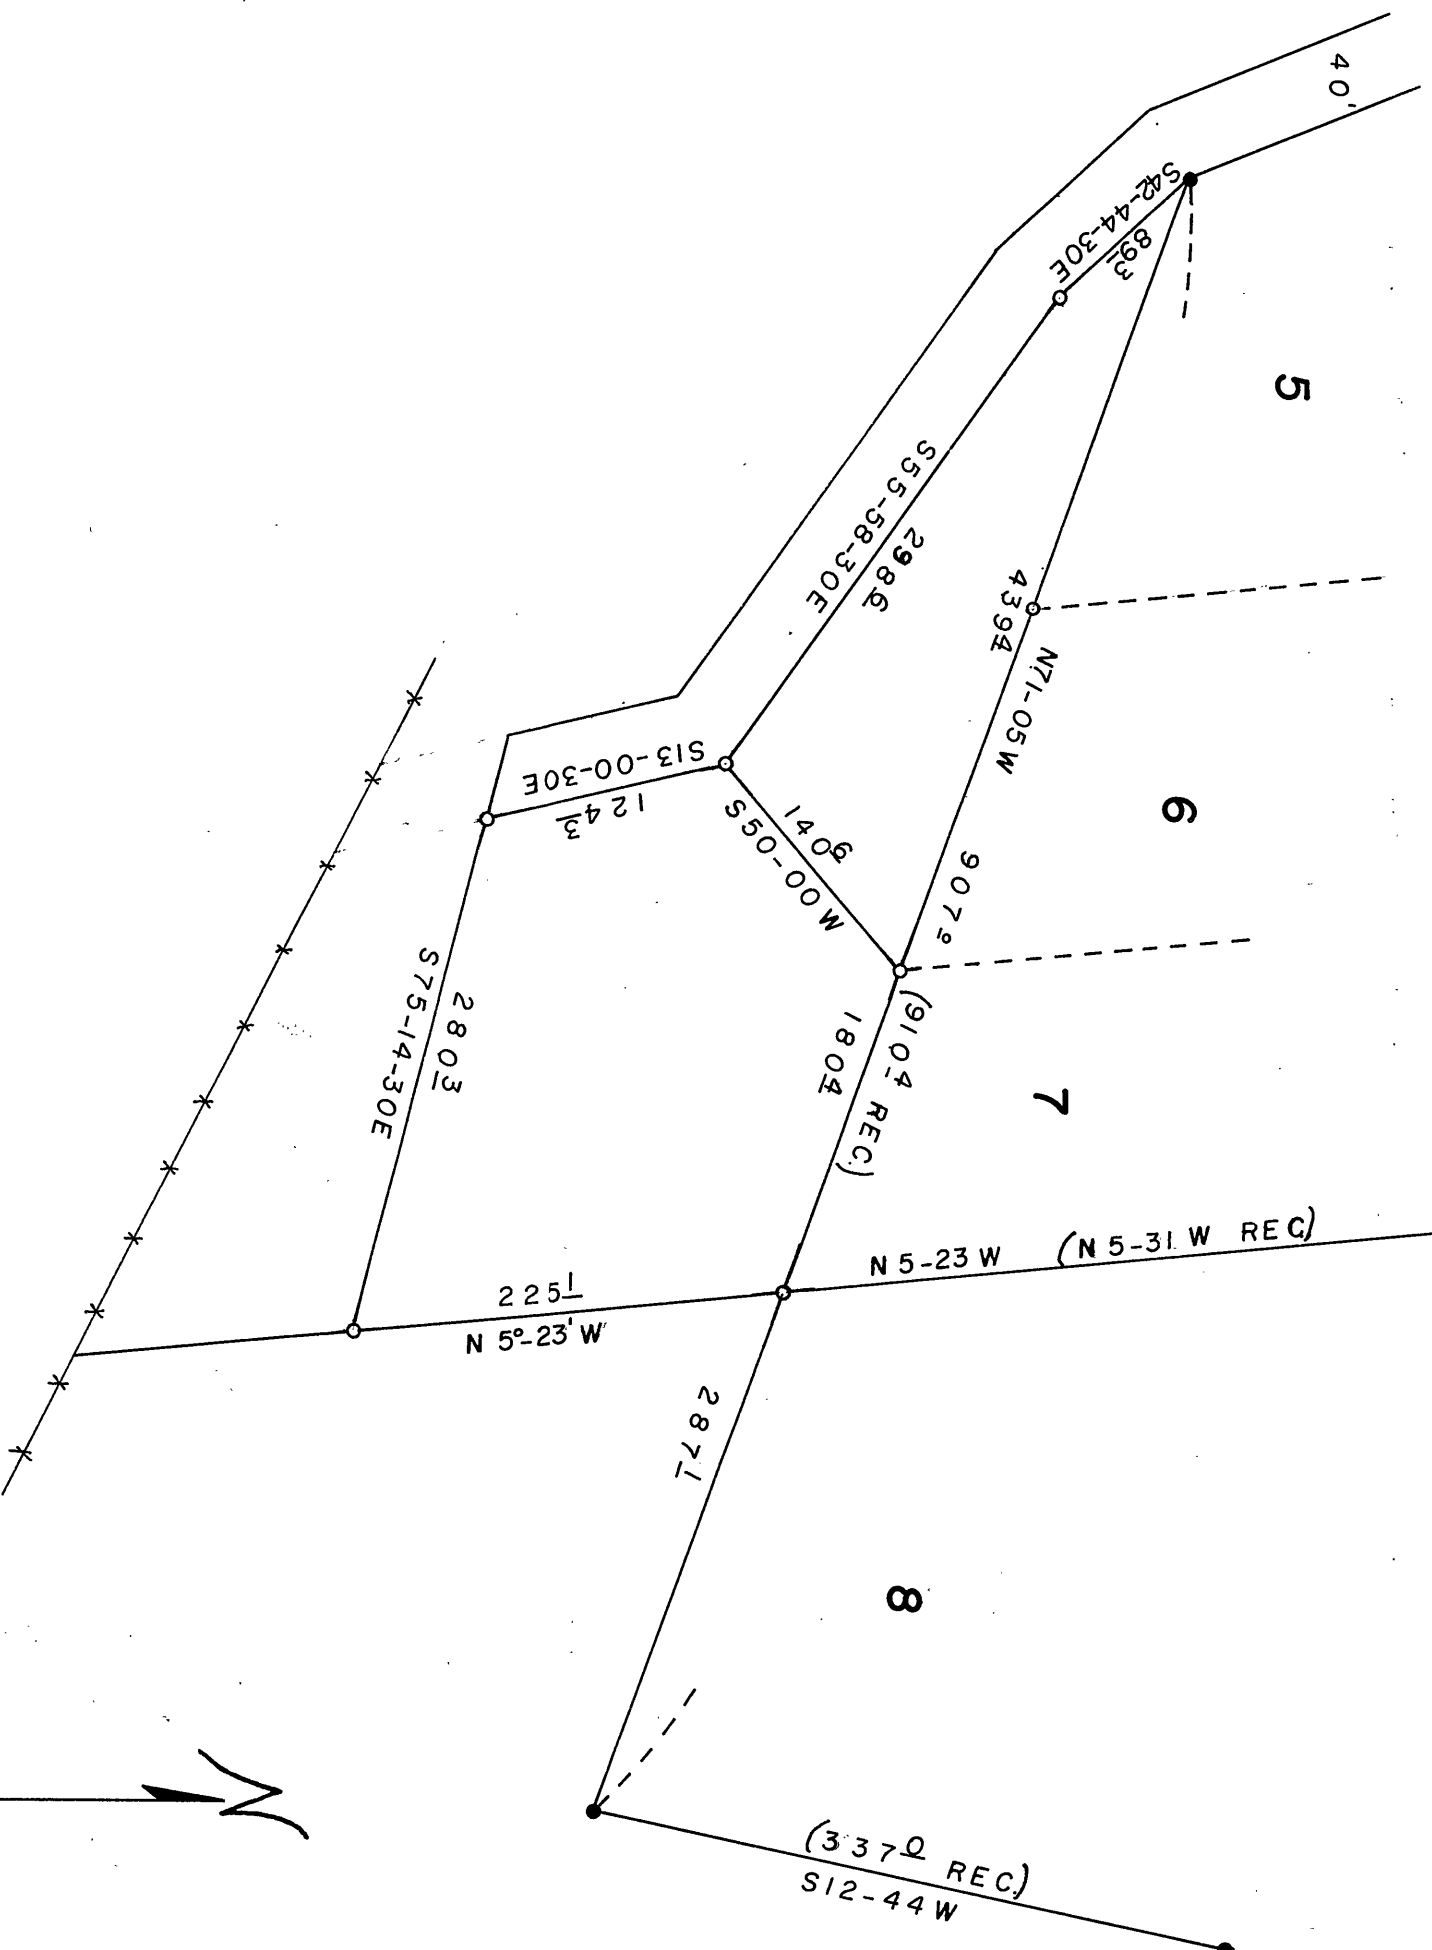


EDGEWOOD TERRACE SUBDIVISION

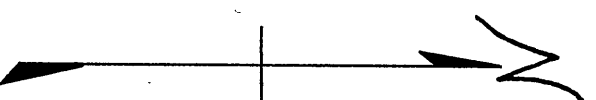

- FD. MONUMENTS
- SET 3/4" IRON PIPE
- BEARINGS BASED ON SL'Y LINE
- OF EDGEWOOD SUBDIVISION

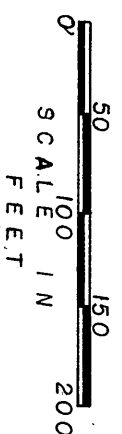

REGISTERED
OREGON
LAND SURVEYOR
Duane I. Griffith
JULY 10, 1964
DUANE I. GRIFFITH
644

RECEIVED AND
FILED
DEC 7 1967
JOHN LIVERA, County Clerk
Deputy

BAGETT & GRIFFITH SURVEYING
JOHN DAY, OREGON
MAP OF SURVEY
A PORTION OF THE NW 1/4 OF
THE NE 1/4, SEC. 1, T14S, R31E, WM.,
GRANT COUNTY, ORE.
SURVEYED FOR DAVID SHEEDY
SURVEYED BY D.I. GRIFFITH 7/28/67
SCALE 1"=100' DRAWN BY GDB 8/1/67