
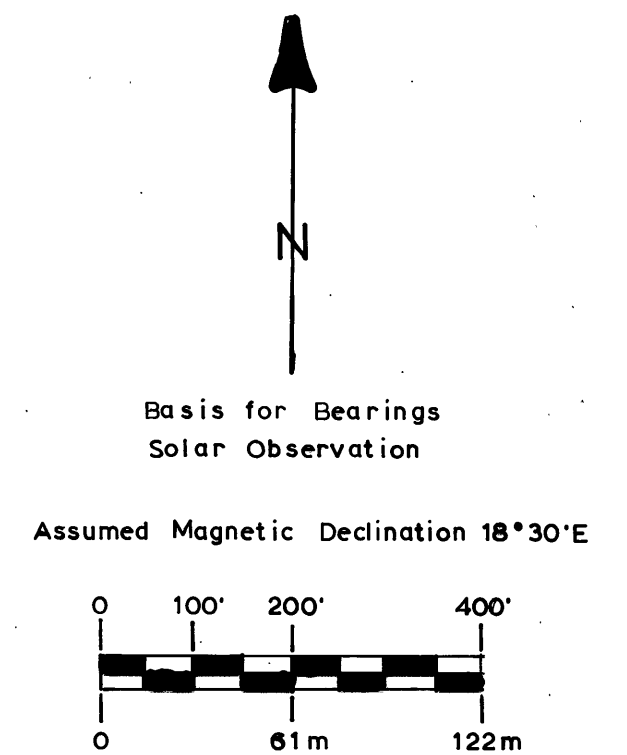


MAP OF SURVEY for the Subdivision of Section 25, T11S, R35E, WM

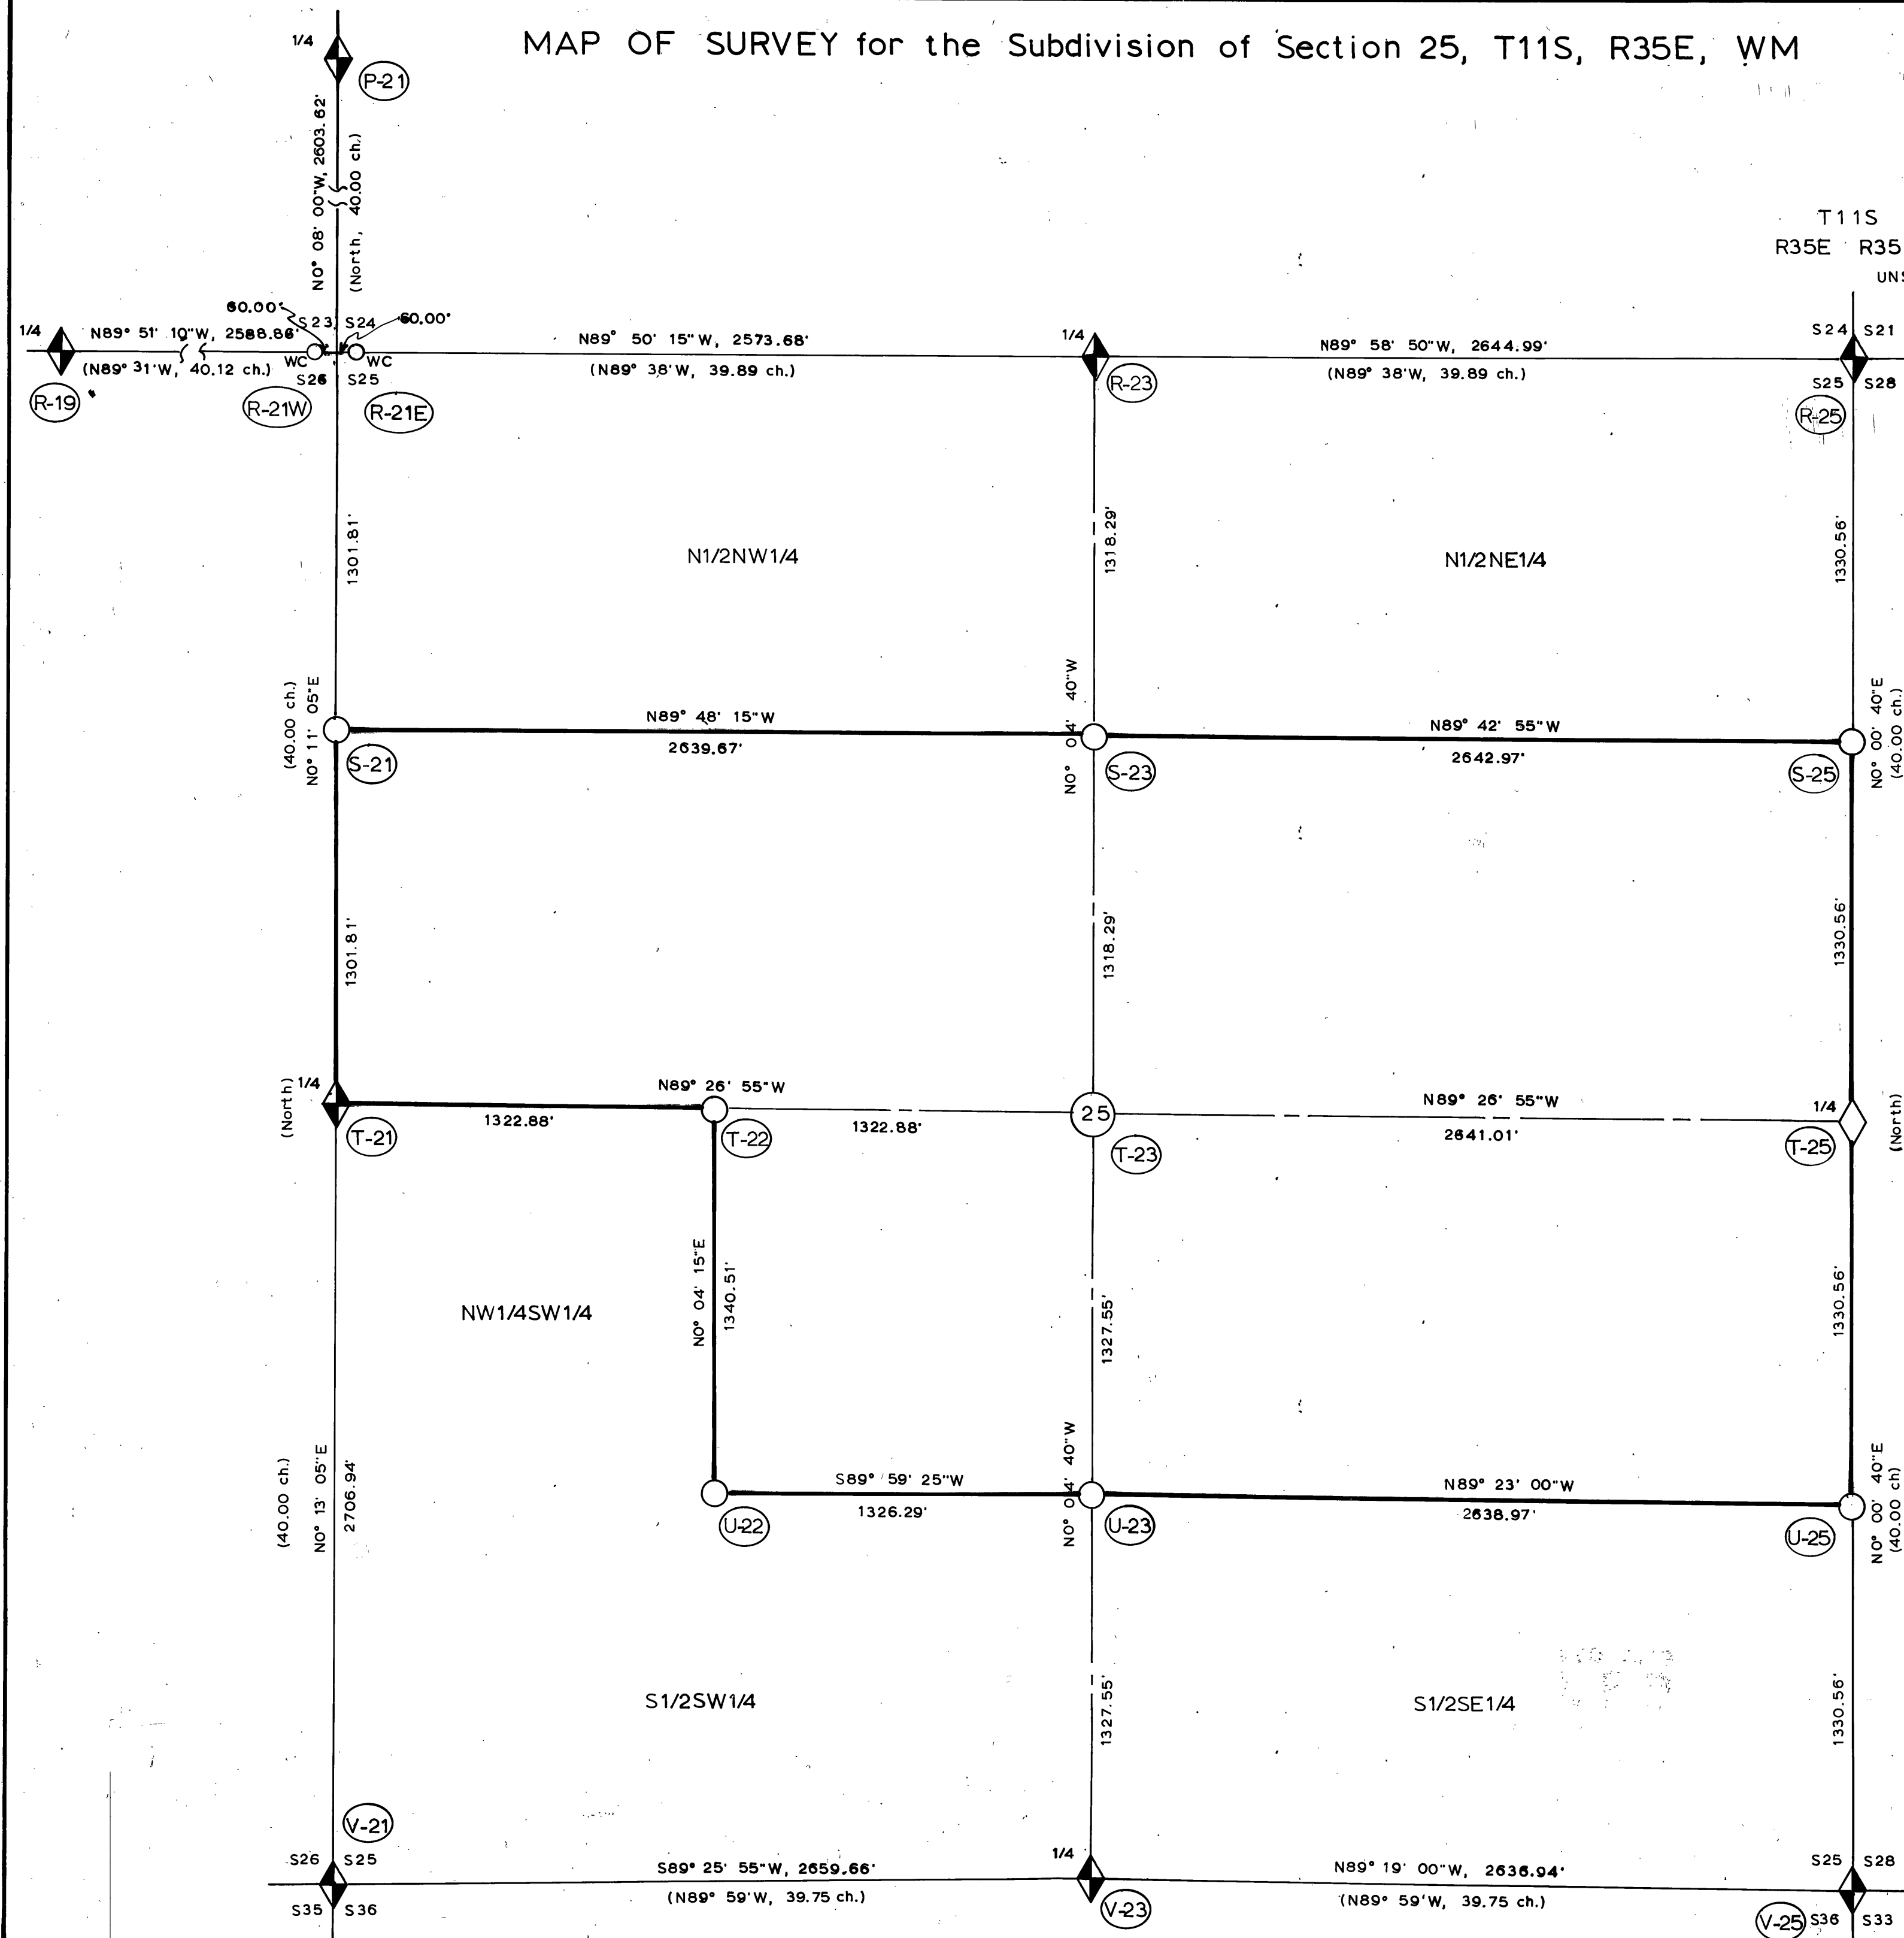

LEGEND

Section & 1/4 Corners Set by Found Evidence

Corners Set by Survey

C1/4 Set

Posted Property Lines

Section Lines

Center Section Lines

Certified Corner Record Index No.
See Corner Restoration Records

Legal Subdivision of USFS Property

Record Bearing & Distance in Parentheses

All monuments are 2" Aluminum Pipes with 3 1/4" Aluminum Caps

See separate Narrative of Survey for additional information.

CERTIFICATION

I, Leland Lee Myers, a Professional Land Surveyor in the State of Oregon, at PO Box 98, Sumpter, OR 97877, do hereby that I did perform this survey between July 31 and September 7, 1985, as a contractor at the request of the USDA-Forest Service by Contract No. 53-04H1-4-9667N and that the information shown hereon is correct to the best of my knowledge.

REGISTERED
PROFESSIONAL
LAND SURVEYOR

OREGON
JULY 7, 1985
LELAND LEE MYERS
699

RECEIVED AND
FILED

OCT 25 1985

OFFICE OF COUNTY SURVEYOR

Attest: *[Signature]*