



Subdivision of Sections 33, 34 & 35,
T.11S., R.30E., and Section 2, T.12S., R.30E.,
W.M., Grant County Oregon.
May, June, Sept. & Oct. 1985
By: Douglas M. Ferguson

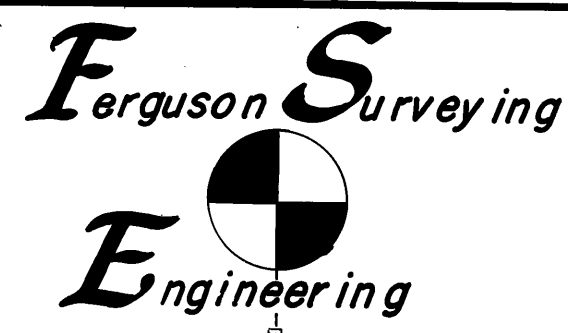

MAG. DEC. +20° E.

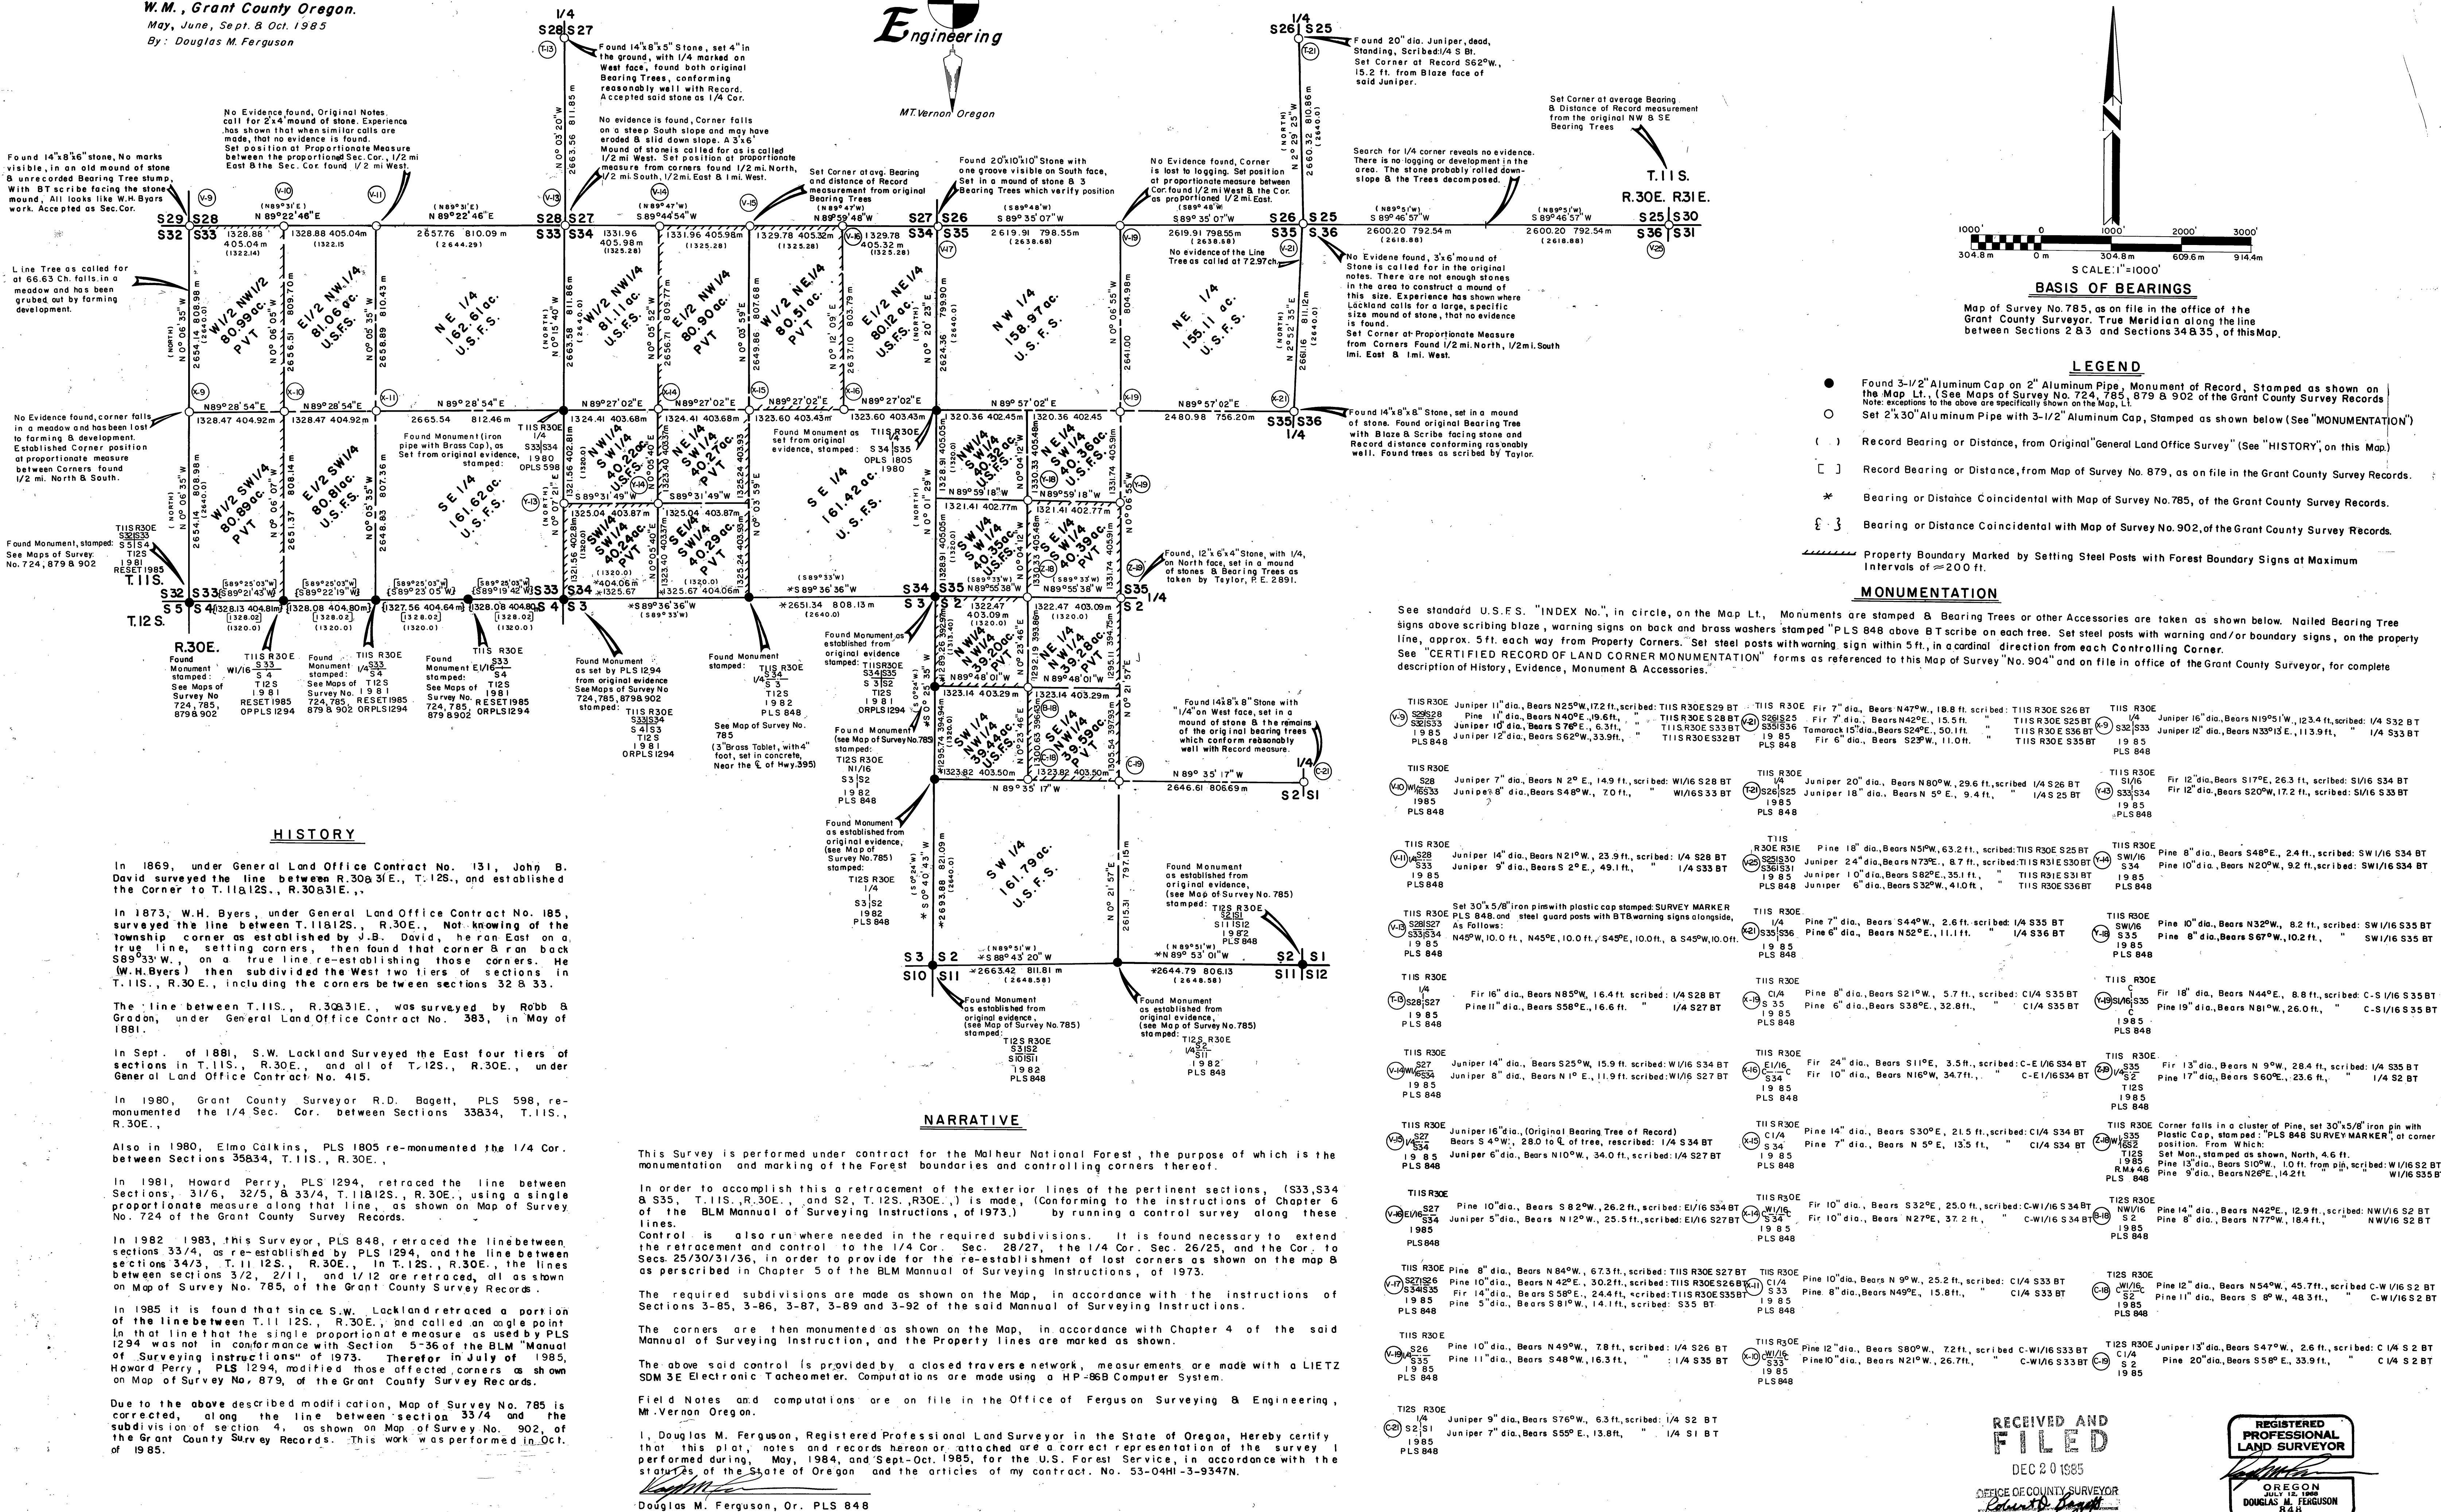

RECEIVED AND
FILED

DEC 20 1985

OFFICE OF COUNTY SURVEYOR
Douglas M. Ferguson
PLS 848

REGISTERED
PROFESSIONAL
LAND SURVEYOR

OREGON
DOUGLAS M. FERGUSON
PLS 848