


1. Fd. Stone 19"X11"X8", (20"X10"X8") on top of Grnd. & out of posititon, no marks, 12" D.B.H. Lodgepole pine, (8") N.24°W., 37.62', (N.24°W., 57 lks., 37.62') dead and down w/scribing. 20" D.B.H. Lodgepole Pine (10") S.45°W., 25.74', (S.45°W., 39 lks., 25.74') w/scribes, dead and down. 11" D.B.H. (10") Lodgepole Pine, S.76°E., 141.24', (S.76°E., 24 lks., 141.24') w/scribes T7SR34ES1BT, on a partially healed face, dead and down. No trace of N.E. B.T. Set; a 2 1/2" diam. Alum. cap on a 2 1/2"X30" alum. pipe at cor. Set at record dist. from B.T.'s. cap marked per sketch. Set steel posts 4' N. & E. w/ signs. 8" D.B.H. Lodgepole pine, S.62°E., 84.7', scribed T7SR34ES1BT. 8" D.B.H. Lodgepole Pine, S.10 1/2°W., 81.44', scribed T7SR34ES2BT. 12" D.B.H. Lodgepole Pine, N.79°W., 82.8, scribed T6SR34ES35BT. 6" D.B.H., Lodgepole Pine, N.17 1/2°E., 19.8', scribed T6SR34ES36BT.
2. 1/4 Cor. Sec's. 35, 2. Fd. Nothing. Set; a 2 1/2" alum. cap in a 2 1/2"X30" alum. pipe at proportioned corner. Raised stone mound. Cap marked per sketch. Set steel posts with Attn. & Mon. signs, 4' E. & W. 12" D.B.H. White Fir, N.83°W., 28.8', scribed 1/4S35BT. 6" D.B.H. Douglas Fir, S.10°E., 32.8', scribed 1/4S2BT.
3. Cor. Sec's. 34, 35, 2, 3. Fd. no trace of stone, 28" D.B.H. (30") Ponderosa Pine snag, N. 83 1/2°E., 107.3' (N.79°E. 156 lks., 102.96') with scribes T6SR34ES25BT. Should be 835. 26" D.B.H. Ponderosa Pine (18"), S.82°E., 83.16', (S.79°E. 126 lks., 83.16') Face down. Down snag. 39" D.B.H. (30") Ponderosa Pine, S.63°W., 103.62', (S.63°W., 157 lks., 103.62'), with scribes ES3 visible on partially open blaze. 36" D.B.H. Ponderosa Pine, down snag, N.65°W., 124.74', (N.68°W., 189 lks., 124.74') scribed T6SR34ES34. Stone mound, of unknown origin, N.80°19'E., 71.5'. Set; a 2 1/2" diam. alum. cap on a 2 1/2"X30" alum. pipe at record distances from 3 B.T.'s. Set a steel post 4' E. & W. with attn. and mon. signs attached. Raised stone mound at corner. 6" D.B.H. Ponderosa Pine, N.33°E., 17.1', scribed T6SR34ES35BT. 8" D.B.H. Douglas Fir, S. 89°E., 73.7', scribed T7SR34ES2BT. 10" D.B.H. Douglas Fir, N.43°W., 65.7', scribed T6SR34ES34BT.
4. CN 1/16. Fd. Nothing. Set; 2 1/2" diam. alum. cap on a 2 1/2"X30" alum. pipe, w/flare at bottom. Cap mkd. per sketch. Set steel posts 4' E. & S. w/prop. bndry., attn. & mon. signs attached. 9" D.B.H. Lodgepole pine, N. 44 1/2°E., 97.1', scribed CN1/16S2BT. 15" D.B.H. Douglas Fir, N.3°W., 63.8', scribed CN1/16S2BT.
5. N 1/16 Sec's. 1 & 2. Fd. Nothing. Set; 2 1/2" diam. alum. cap on a 2"X30" alum pipe w/lower end flared, at point for corner, cap mkd. per sketch. Set steel posts 4' E. & S. form corner w/prop. bndry., attn. and mon. signs attached. 9" D.B.H. Lodgepole Pine, N.65°E., 35.4' scribed N1/16S1BT. 10" D.B.H. Lodgepole Pine, S.4°W., 79.9', scribed N1/16S2BT.
6. 1/4 Cor. Sec's. 1 & 2. Fd. Stone, 13"X11"X5", w/chisel mks., at record bearing and distance from remaining B.T., which bears S.33°W. 30.36' (S.33°W., 46 lks., 30.36') a Lodgepole Pine, snag, w/scribes in upper blaze "43", lower blaze healed. No trace of S.E. B.T. Set; 2 1/2" diam. alum. cap on a 2 1/2"X30" alum. pipe at corner and buried cornerstone alongside pipe. Set steel posts 4' E. & N. with mon., attn. & prop. bndry. signs attached. 9" D.B.H. Lodgepole Pine, S.72 1/2°W., 8.1', scribed 1/4S2BT. 13" D.B.H. Lodgepole Pine, S.42°E., 19.2', scribed 1/4S1BT. Raised stone mound.
7. CE 1/16. Fd. Nothing. Set; 2 1/2" alum. cap on a 2 1/2"X30" alum. pipe, w/flare at bottom, at point for corner. Cap mkd. per sketch. Set steel posts 4' E. & S. w/prop. bndry., attn. & mon. signs attached. Meadow Crk., north, 50'. 8" D.B.H. Lodgepole Pine, N. 18°E., 170.0' scribed CE1/16S2BT. 7" D.B.H. Lodgepole Pine, N. 72 1/2°W., 40.5', scribed CE1/16S2BT.
8. C 1/4 Cor. Fd. Nothing. Set; 2 1/2" diam. alum. cap on a 2"X30" alum. pipe, w/flare at bottom. Cap mkd. per sketch. Set steel posts 4' N. & W. w/mon. signs attached. 8" D.B.H. Lodgepole Pine, S.5°W., 82.4', scribed C1/4S2BT. 8" D.B.H. Lodgepole Pine, N. 57°E., 205.7', scribed C1/4S2BT.
9. CW 1/16 Fd. Nothing. Set; 2 1/2" alum. cap on a 2"X30" alum. pipe, w/flare at bottom, at point for corner cap mkd. per sketch. Set steel posts 4' E. & S. w/prop. bndry., attn. & mon. signs attached. 10" D.B.H. Lodgepole Pine, N. 22°E., 26.9', scribed CW1/16S2BT. 7" D.B.H. Lodgepole Pine, N. 47°W., 12.6', scribed CW1/16S2BT.
10. 1/4 Cor. Sec's. 2, 3. Fd. Nothing. Set; 2 1/2" diam. alum cap on a 2 1/2"X30" alum. pipe at proportioned corner. Cap mkd. per sketch. Set steel posts with attn. & mon. signs, attached, 4' N. & S. 7" D.B.H. Lodgepole Pine, S.1°E., 13.9' to center of side of tree midway btwn. blazes, scribed, 1/4S2BT. Down 10/13/86. 8" D.B.H. Spruce, S. 47 1/2°W., 37.8', scribed 1/4S3BT. 9" D.B.H. Lodgepole Pine, S.60°E., 68.0', scribed 1/4S2BT.
11. SW 1/16. Fd. Nothing. Set 2 1/2" diam. alum. cap on a 2"X30" alum. pipe w/flare at bottom. Raised stone mound, 4'X6'X4' high. Cap mkd. per sketch. 6" D.B.H. Lodgepole Pine, S.68°E., 4.8', scribed SW1/16S2BT. 5" D.B.H. Lodgepole Pine, S.71°W., 17.9', scribed XBT.
12. CS 1/16. Fd. Nothing. Set; 2 1/2" diam. alum. cap on a 2"X30" alum. pipe, w/flare at bottom, at point for corner. Cap mkd. per sketch. Set steel posts 4' E. & W. w/prop. bndry., & mon. signs attached. 9" D.B.H. Lodgepole Pine, N. 14°W., 40.9', scribed CE1/16S2BT. 12" D.B.H. Lodgepole Pine, S.37°E., 29.0' scribed CS1/16S2BT.
13. SE 1/16 Fd. Nothing. Set; 2 1/2" alum. cap on a 2 1/2"X30" alum. pipe, w/flare at bottom, at point for corner. Cap mkd. per sketch. Set steel posts 4' E. & N. w/prop. bndry., attn. & mon. signs attached. 4" D.B.H. White Fir, S.71°W., 75.8', scribed XBT. 10" D.B.H. Subalpine Fir, N. 60°E., 110.4', scribed SE1/16S2BT.
14. Cor. Sec's. 1, 2, 11, 12. Fd. Post gone, orig. B.T.'s. (7" pine) N.60°E., 30.4' (N.60°E., 46 lks., 30.4') down and rotted. B.T. scribes visible on piece of trunk. 12" D.B.H., (8") Lodgepole Pine, down, w/scribes T7SR34ES11BT, S.36°W., 18.48' (S.36°W., 28 lks., 18.48'). (7" diam. pine), down and rotted, no visible scribes, S.44°E., 21.12' (S.44°E., 32 lks., 21.12') (8" diam. pine), down and on face, on piece of wood chopped out are scribes, N.81°W., 11.88' (N.81°W., 18 lks., 11.88'). Set; 2 1/2" diam. alum. cap on a 2 1/2"X30" alum. pipe at record distances from B.T.'s. Cap mkd. per sketch. Set steel posts 4' E. & W. with attn. & mon. signs attached. 6" D.B.H. White Fir N. 57°E., 36.8', scribed T7SR34ES1BT. 9" D.B.H. Spruce, S.86 1/2°E., 39.3' scribed T7SR34ES12BT. 5" D.B.H. White Fir, N17 1/2°W., 8.2', scribed "X"BT. 10" D.B.H. Spruce, S.15°W., 26.4', scribed T7SR34ES11BT.
15. 1/4 Cor. Sec's. 2, 11. Fd. Nothing. Set; 2 1/2" diam. alum. cap on a 2 1/2"X30" alum. pipe at proportioned point for corner. Old creek bed, 100' East, road 80' West. Cap mkd. per sketch. Set steel posts with attn. & mon. signs attached, 4' E. & W. 5" D.B.H. Lodgepole Pine, S.1°E., 44.7' scribed X in upper 5' blaze and BT in lower blaze. 12" D.B.H. Lodgepole pine, N.80°E., 22.9', scribed 1/4S2BT.
16. Cor. Sec's. 2, 3, 10, 11. Fd. No trace of corner post. 12" D.B.H. (8") Lodgepole Pine, S.57°E., 3.96' (S.57°E., 6 lks., 3.96') w/scribing on partially healed face, T7SR34ES11B. Dead, down & rotted. Rotted pieces of stump, S.62°W., 3.3', (S.62°W., 5 lks., 3.3'). No scribes visible. 10" D.B.H., (7") Lodgepole Pine, N.72°W., 5.28' (N.72°W., 8 lks., 5.28') dead and down w/scribes T7SR34ES3BT. No trace of N.E. B.T. Set; 2 1/2" diam. alum. cap on a 2 1/2"X30" alum. pipe at record distances from B.T.'s. Cap mkd. per sketch. Set a steel post w/attn. & mon. signs attached. 14" D.B.H. Spruce, N2 1/2°W., 33.5', scribed T7SR34ES3BT. 12" D.B.H. White Fir, N.83°E., 13.3' scribed T7SR34ES2BT. 40" D.B.H. Tamarack, S.84 1/2°E., 76.8', scribed T7SR34ES11BT. 30" D.B.H. Tamarack, S.53°W., 90.3', scribed T7SR34ES10RT.


Each B.T. set by me has a brass washer mkd. RPLS 1910 set between B&T. All B.T.'s. have E.T. tags, attn signs, bands and faces painted red.  
Distance from corner to B.T. is to center of tree 1 foot above root crown.

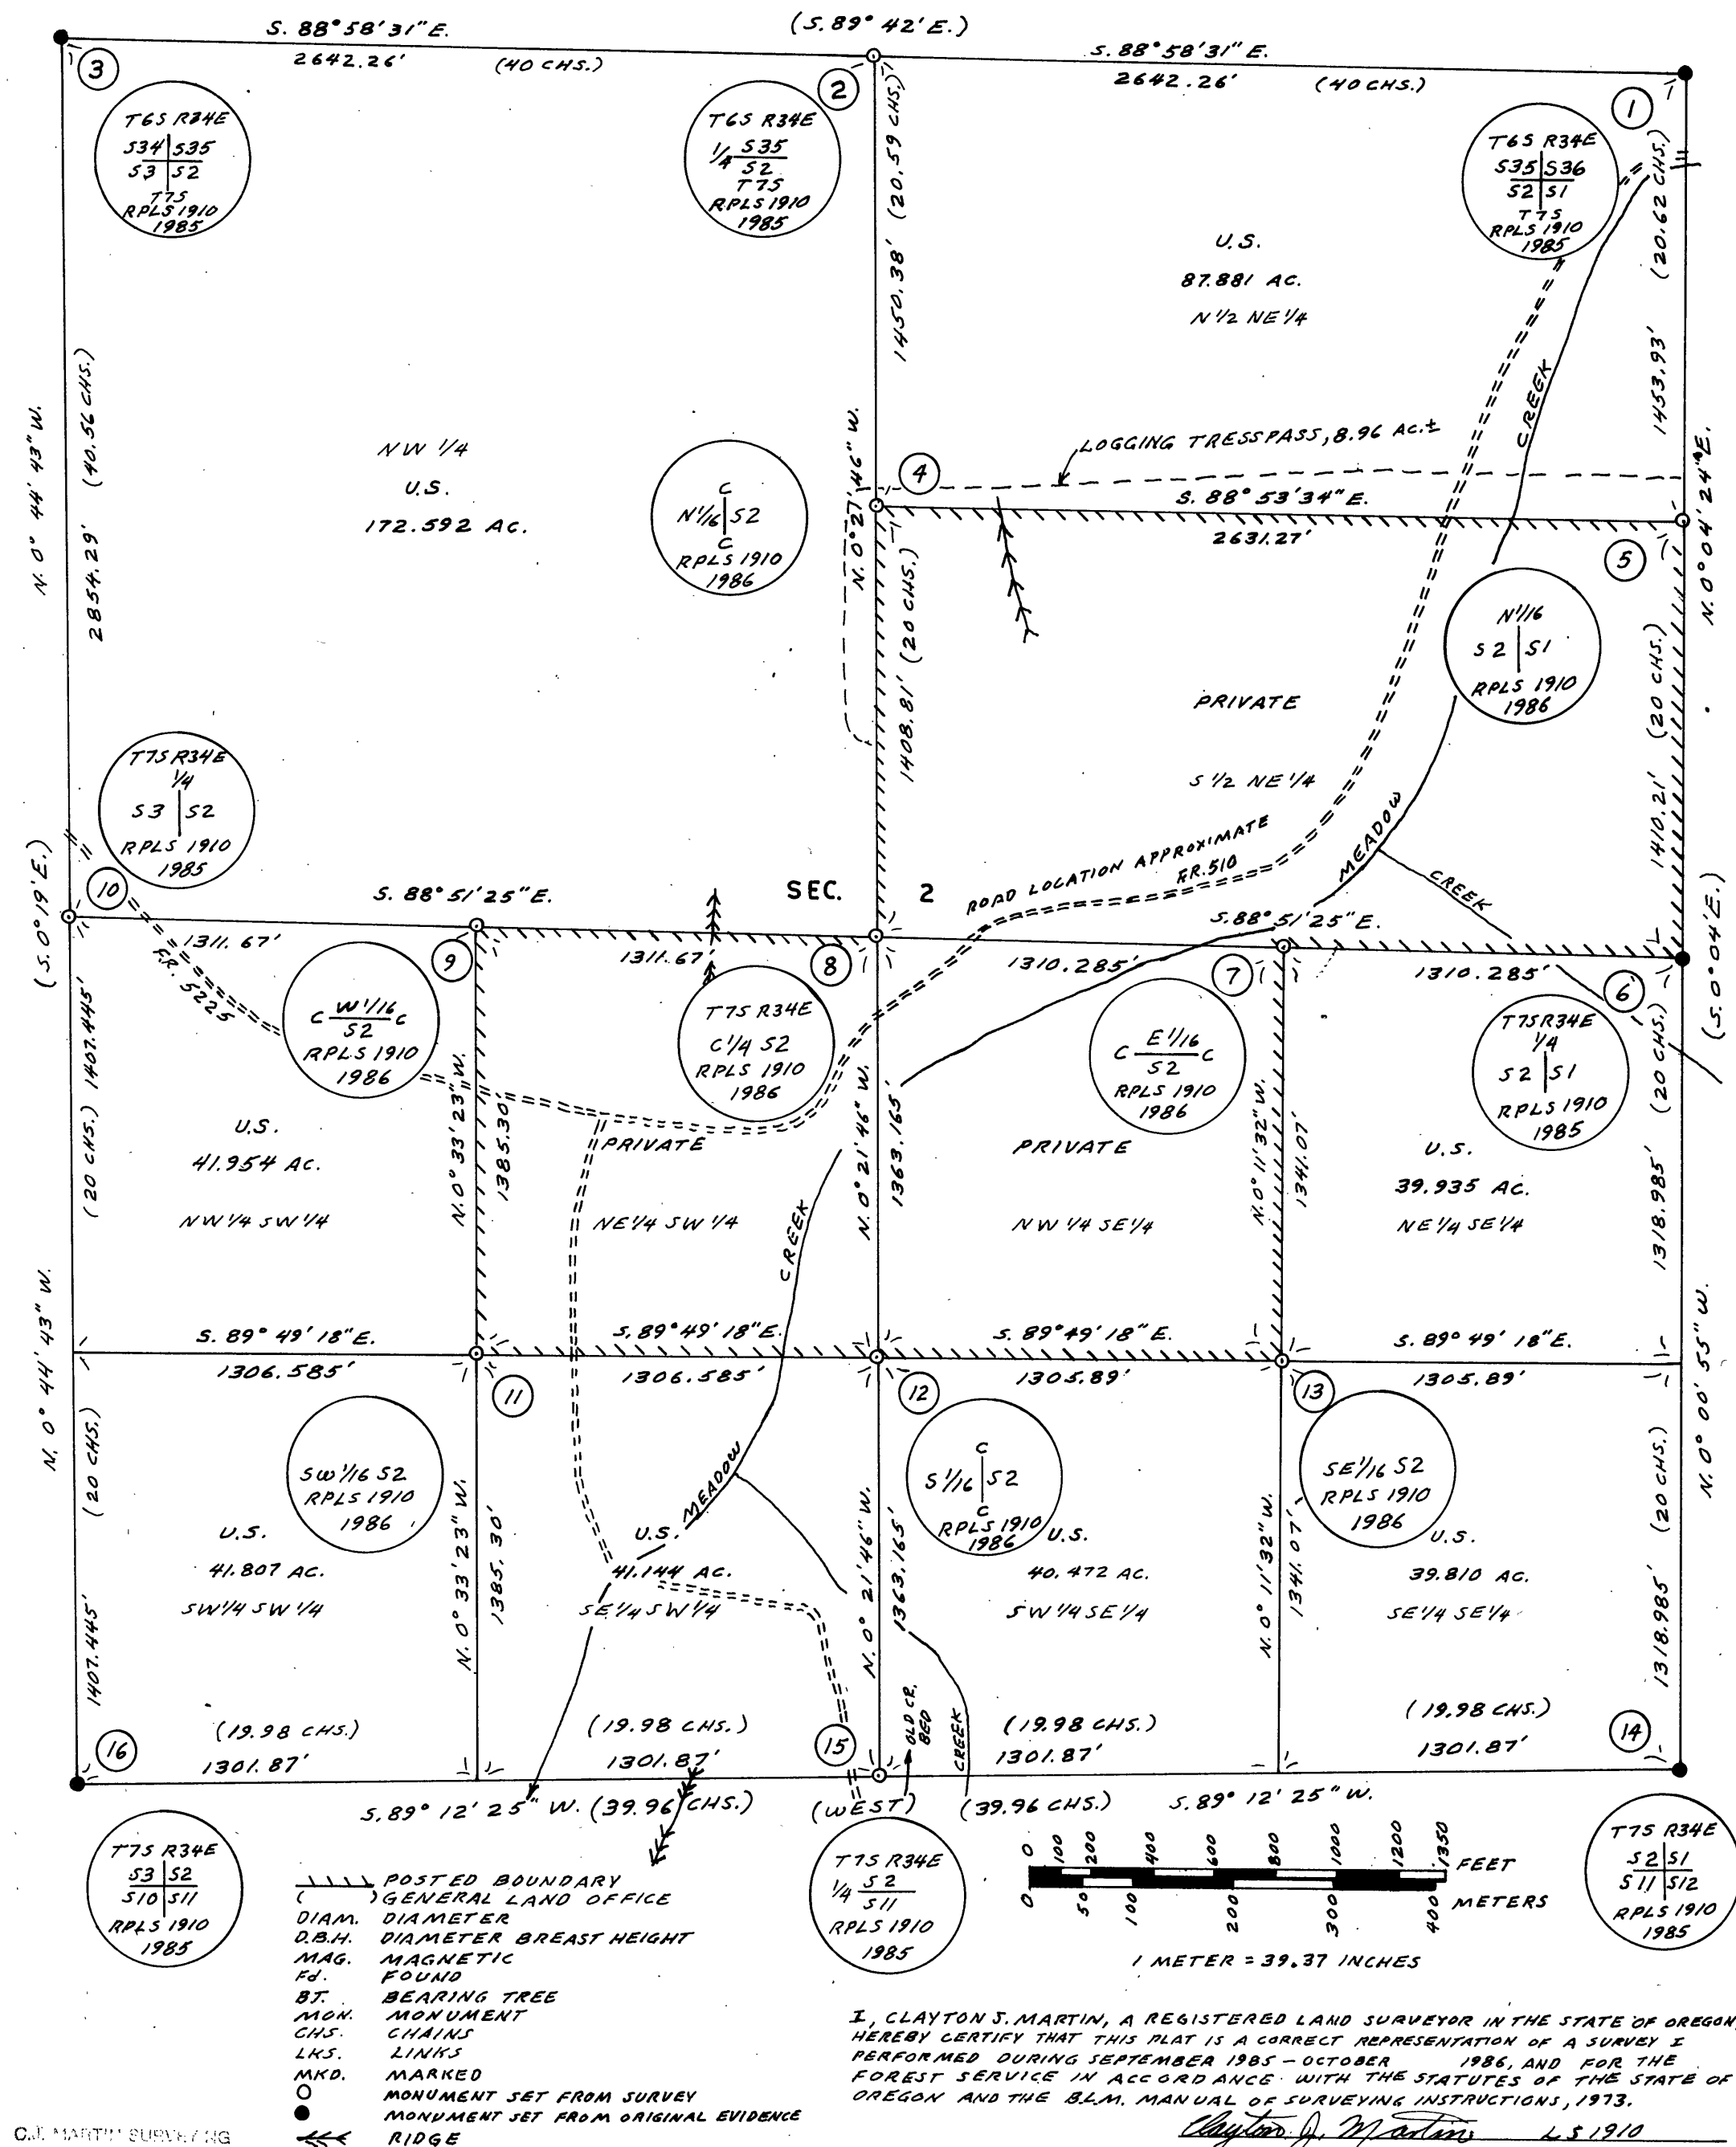

C.J. MARTIN SURVEYING  
2301 10TH ST.  
SWEET HOME, OR 97136

REGISTERED  
PROFESSIONAL  
LAND SURVEYOR

CLAYTON J. MARTIN  
JULY 10, 1980  
OREGON  
CLAYTON-JESSE MARTIN  
1910

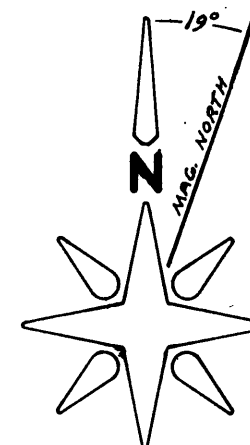

I, CLAYTON J. MARTIN, A REGISTERED LAND SURVEYOR IN THE STATE OF OREGON, HEREBY CERTIFY THAT THIS PLAT IS A CORRECT REPRESENTATION OF A SURVEY I PERFORMED DURING SEPTEMBER 1985 - OCTOBER 1986, AND FOR THE FOREST SERVICE IN ACCORDANCE WITH THE STATUTES OF THE STATE OF OREGON AND THE B.L.M. MANUAL OF SURVEYING INSTRUCTIONS, 1973.  
*Clayton J. Martin* LS 1910

SURVEY FOR UMATILLA NATIONAL FOREST  
FORKS 1985 CADASTRAL SURVEY, CONTRACT No.53-04R35-1462  
SEC. 2, T.7 S., R.34 E., W.M., GRANT COUNTY, OR  
SCALE: 1"=500' SEP. 1985-OCT. 1986  
SURVEYOR: C.J. MARTIN LS. 1910  
CHAINMAN: J.J. MARTIN R.D. THRASH

RECEIVED AND  
FILED

DEC 31 1986

TRAVERSE, MONUMENT, POSTING, TOPO-  
TIES, SEE BOOK I.

SEE ADDITIONAL SHEET FOR NARRATION.

MAP OF SURVEY NO. 909