



RECEIVED AND
FILED
DEC 14 1967
JOHN LIVEIRA, County Clerk
By _____ Deputy

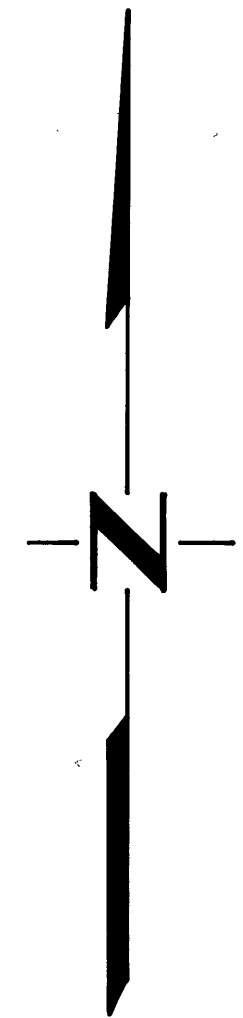

BASIS OF BEARINGS
Record bearing between
NW cor. sec. 1 & W. 1/4 cor.
sec. 1, T. 14 S., R. 31 E., W. M.
as recorded by G. L. O. resurvey
in 1923.

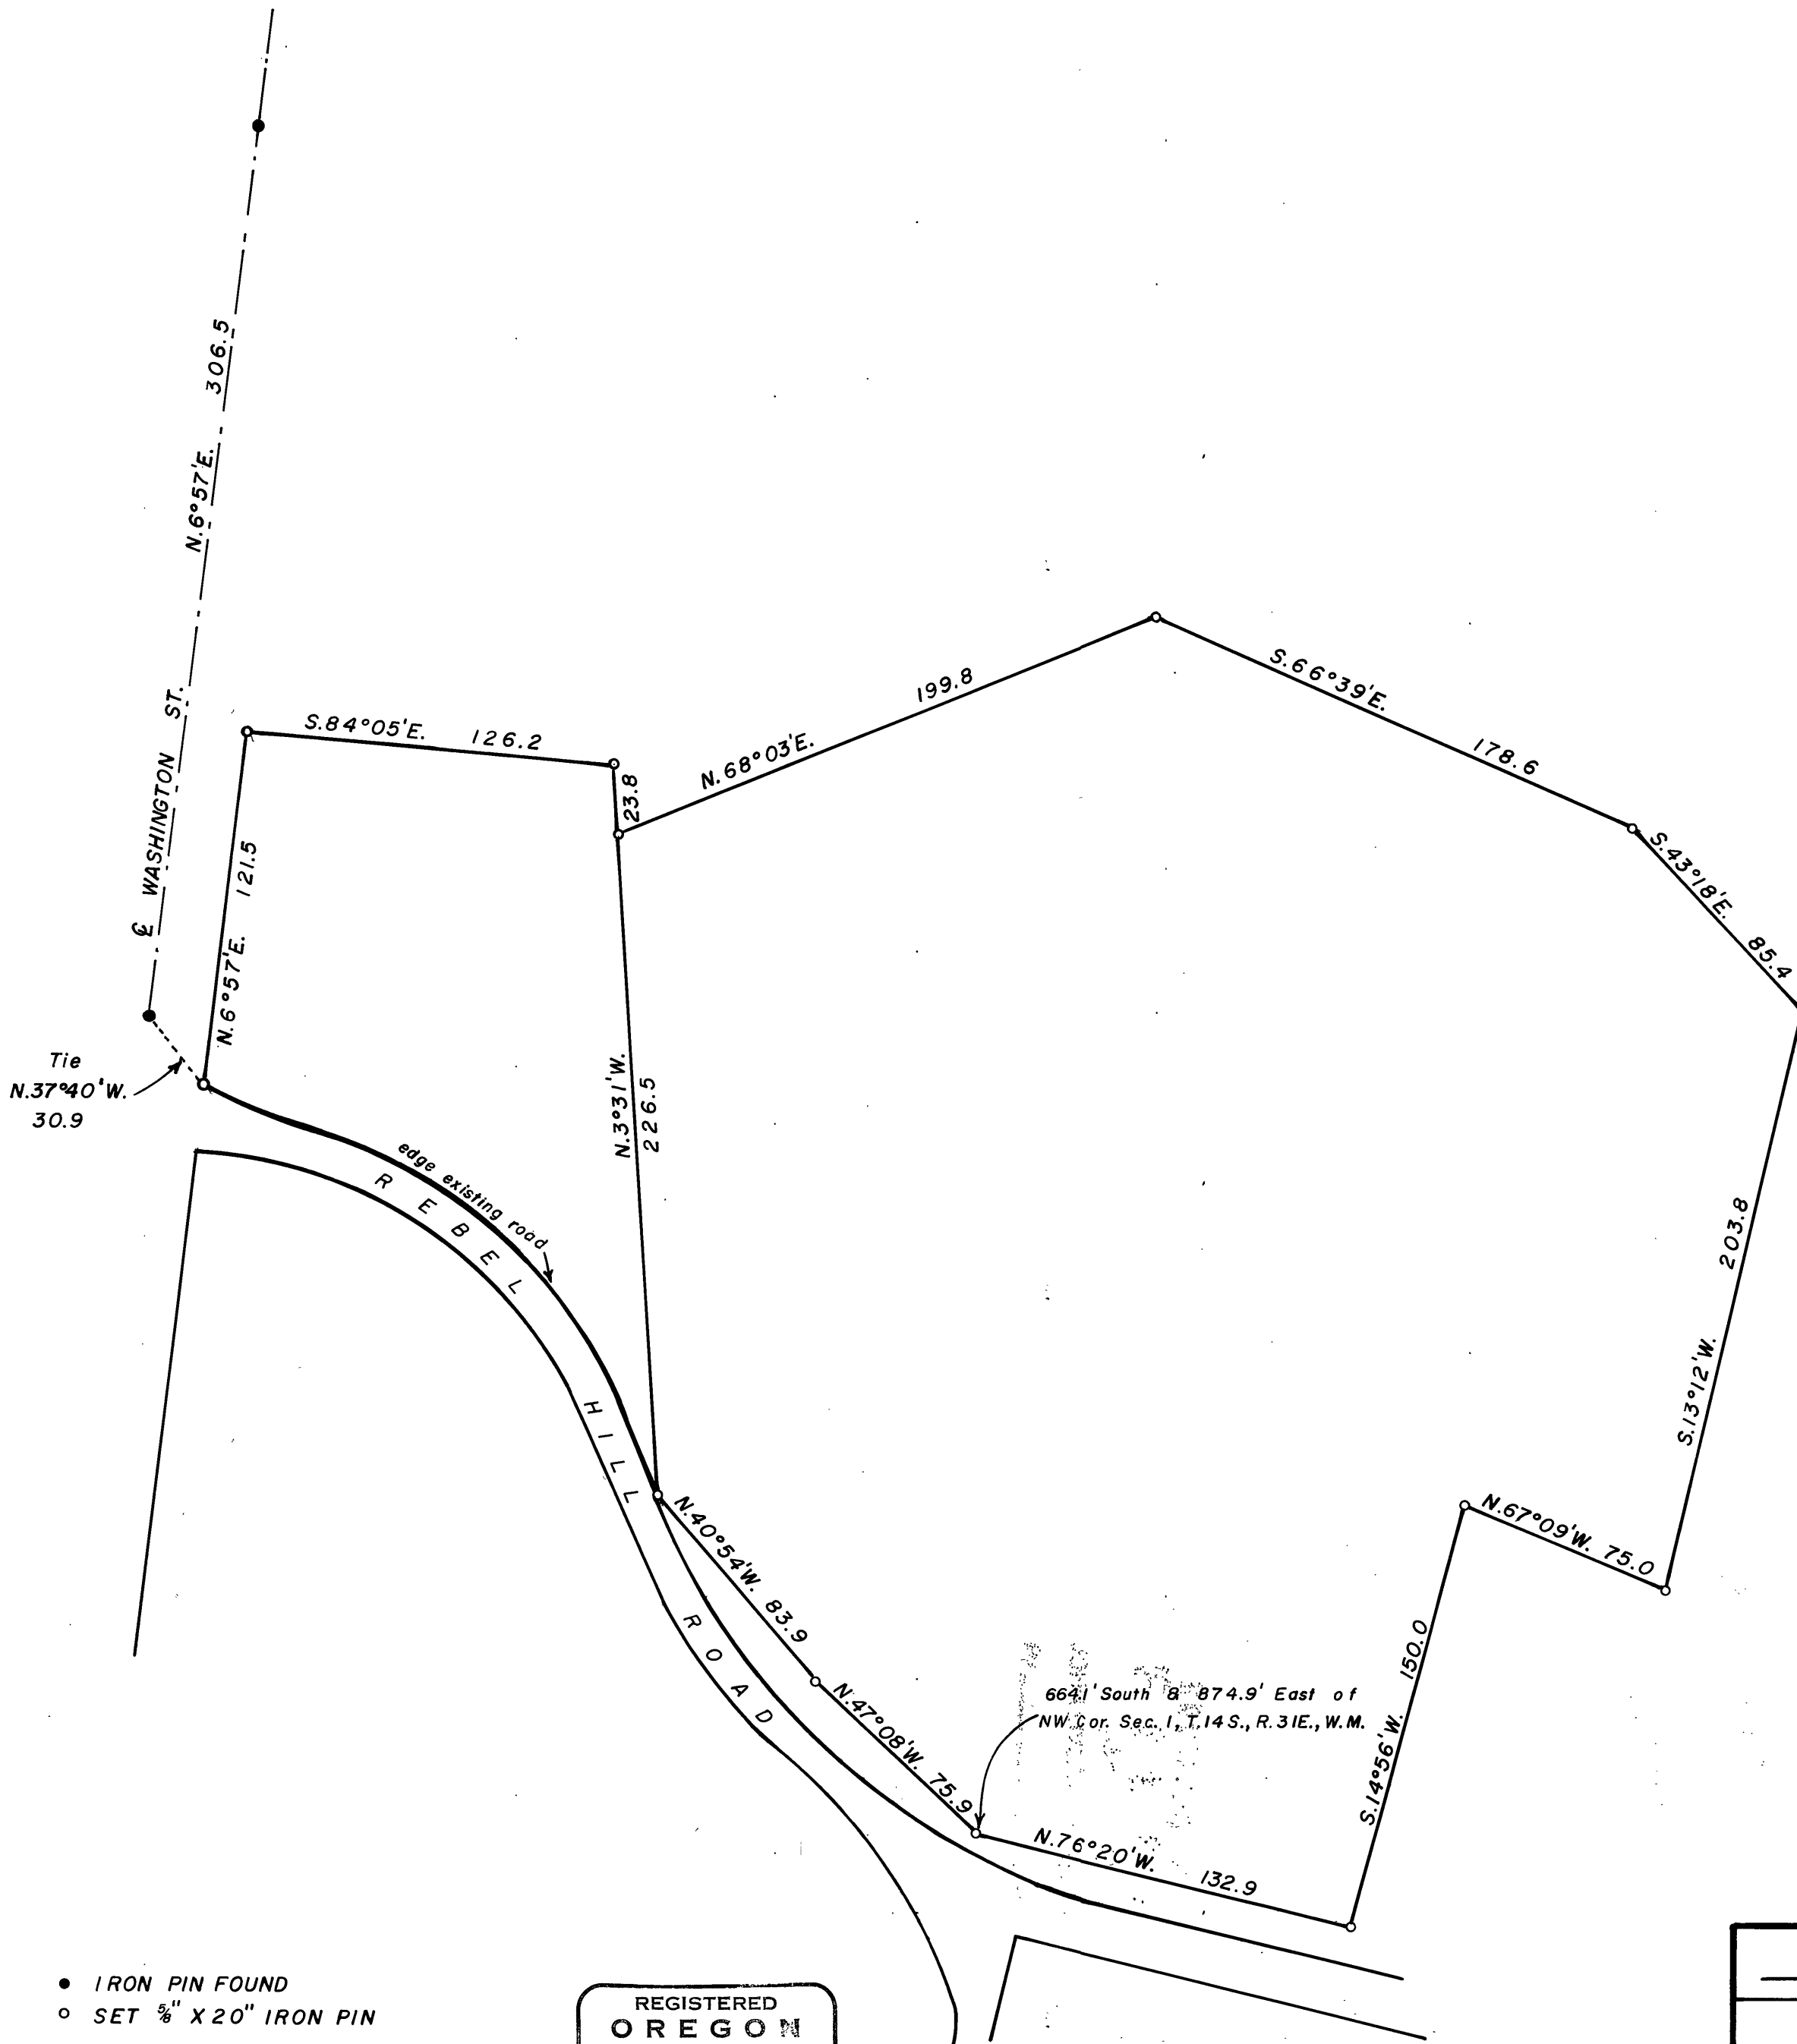

• IRON PIN FOUND
○ SET 5/8" X 20" IRON PIN

REGISTERED
OREGON
LAND SURVEYOR
Robert D. Baggett
JULY 12, 1963
ROBERT D. BAGETT
598

BAGETT & GRIFFITH SURVEYING JOHN DAY, OREGON	
MAP OF SURVEY	
2 PARCELS OF LAND IN THE NW 1/4 NW 1/4 SEC. 1, T. 14 S., R. 31 E., W. M.	
SURVEYED FOR RAMONA MORRIS & T. G. LEWIS	
SURVEYED BY R. D. B. & D. I. G.	12-3-67
SCALE - 1" = 50'	DRAWN BY R. D. B. 12-4-67