

SEE MAP 4

SEE MAP 6

S 7 S 8 (N89° 26' W) N89° 51' 35" W
S18 S17 1318.02' (20.18 ch)
1966-B
J-6
1318.02' (20.18 ch)
J-7
S 8 S 9 S17 S16

NO° 40' 30" W
2676.35'
(40.00 ch)


NO° 44' 35" W
2691.48'

E1/2NW1/4

NO° 48' 40" W
2706.60'

Assumed Magnetic Declination 18° 30' E

Basis for Bearings
Solar Observation

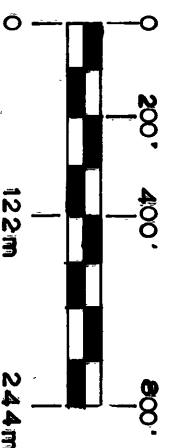

NE 1/4

(North)

1/4 L-5

1321.54'

N89° 12' 20" W L-6

1321.54'

L-7

17

1370.25'

N89° 12' 20" W L-8

1370.25'

1981-A

1/4

NO° 00' 05" E
2666.80'
(40.00 ch)

NO° 48' 40" W
2657.74'

NO° 10' 00" W
2652.15'

E1/2SE1/4

1981-A

T12S

R33E R34E

S13 S18 N89° 56' 00" E 5382.79'
S24 S19 (S89° 42' E, 60.50 ch) S19 S20
1966-B

(40.09 ch)
2660.62'

N-7

1/4

(20.045 ch)
1340.31'

N-8

(20.045 ch)
1340.31'

S17 S16
S20 S21
1981-A

NO° 28' 50" E 1323.66'
(1323.55')
NO° 28' 40" E 1323.23'
(1323.55')

SEE GRANT COUNTY MAP OF SURVEY NO. 694

MAP OF SURVEY for the Subdivision of Section 17, T12S, R34E, WM

LEGEND

- Section & 1/4 Corners Monumented by Others
- Section & 1/4 Corners Set by Found Evidence
- Section & 1/4 Corners Set by Survey
- 1/16th Corners Set by Survey
- C 1/4 Set by Survey
- Posted Property Lines
- Section Lines
- Center Section Lines
- Projected Section Lines
- Certified Corner Record Index No.
See Corner Restoration Records
- Legal Subdivision of USFS Property
- Record Bearing & Distance in Parentheses (40.00 ch)
- See separate Narrative of Survey for additional information.

Year Monumented - Type of Monument Found

1966-B

Types of Monuments Found - See Narrative for Monument History

- A - 2" Aluminum Pipe with 3 1/4" Aluminum Cap
- B - 2" Galvanized Pipe with 2 1/2" Brass Cap
- Monuments Set This Survey are Type A.

CERTIFICATION

I, Leland Lee Myers, a Professional Land Surveyor in the State of Oregon, at PO Box 98, Sumpter, OR 97877, do hereby certify that I did perform this survey October 27 to November 17, 1985, as a contractor at the request of the USDA-Forest Service by Contract No. 53-04H1-4-9867N and that the information shown hereon is correct to the best of my knowledge.



RECEIVED AND
FILED
OCT 10 1985

