
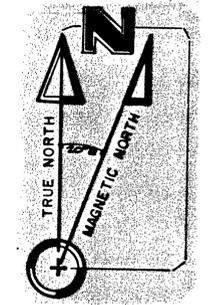


PLAT OF DEVIL'S DREAM AND MAIDEN'S DREAM - MS 599
 LOCATED IN SECTIONS 10, 13, & 16, T9S R36E, WM, BAKER AND GRANT CO, OREGON

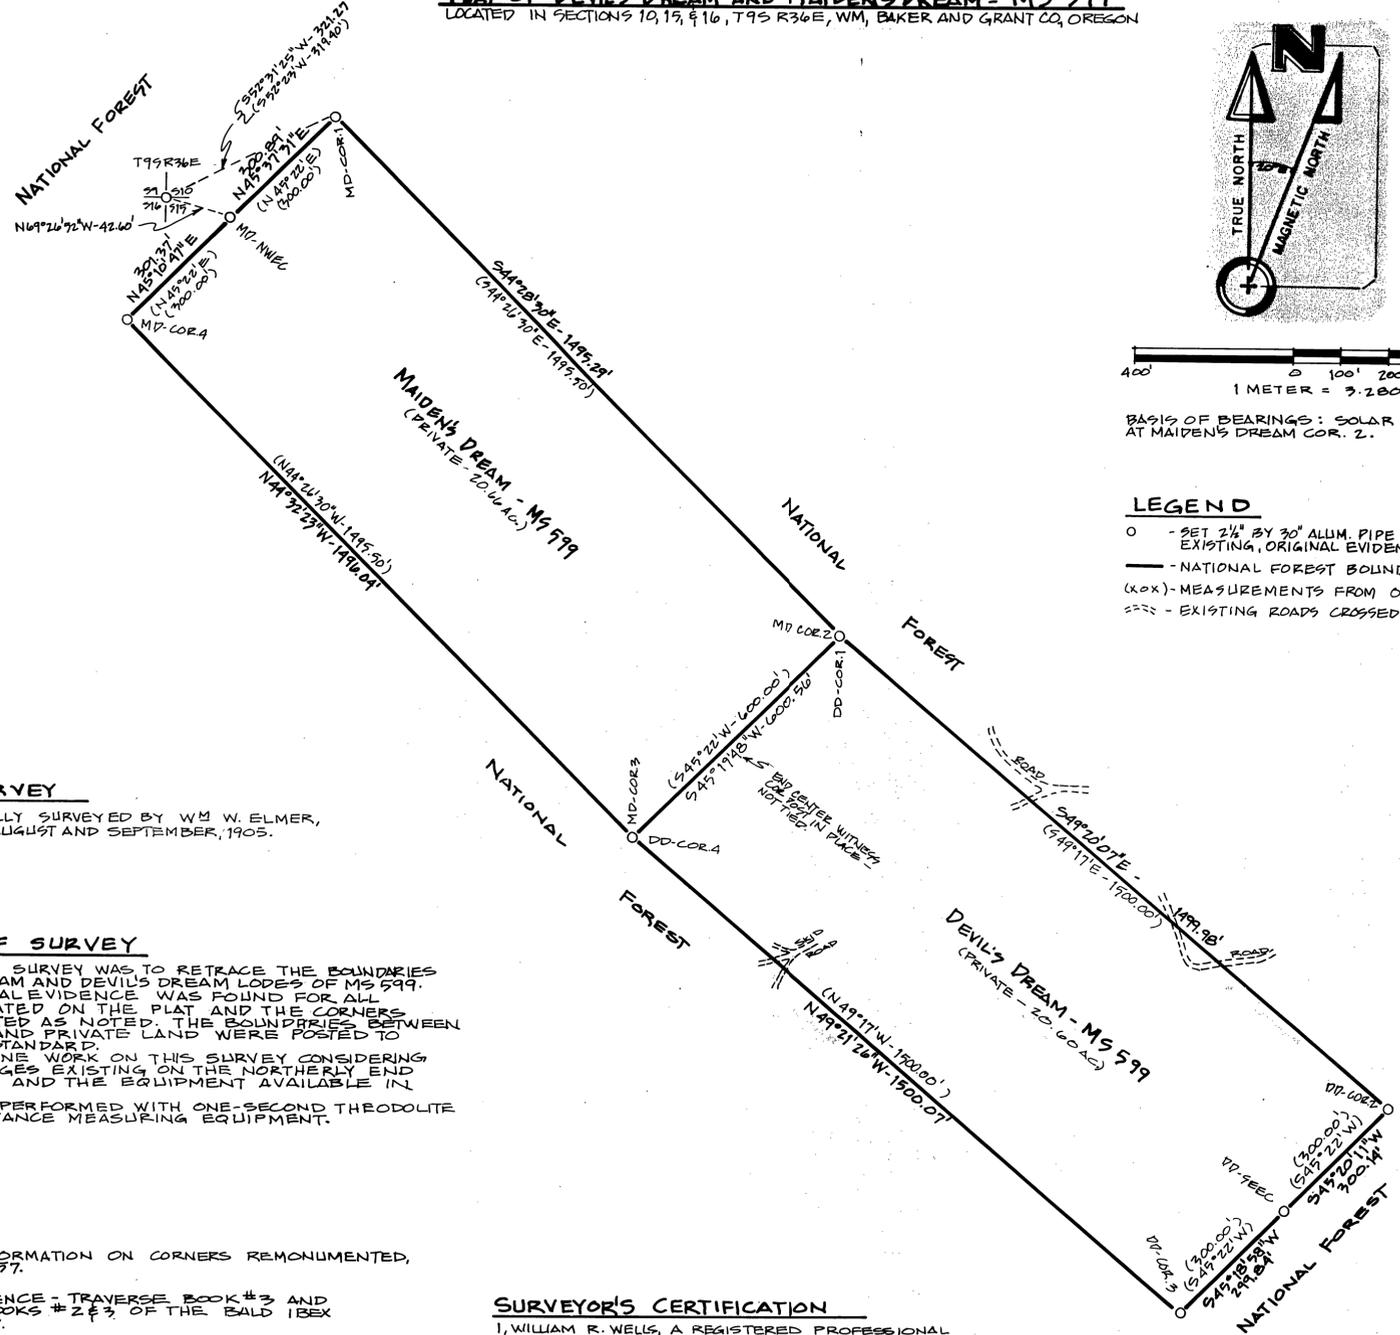

BASIS OF BEARINGS: SOLAR OBSERVATION AT MAIDEN'S DREAM COR. 2.

LEGEND

- - SET 2 1/2\"/>

HISTORY OF SURVEY

MS 599 WAS ORIGINALLY SURVEYED BY WM W. ELMER, FOR C.J. JOHNS, IN AUGUST AND SEPTEMBER, 1905.

NARRATIVE OF SURVEY

THE PURPOSE OF THIS SURVEY WAS TO RETRACE THE BOUNDARIES OF THE MAIDEN'S DREAM AND DEVIL'S DREAM LOTS OF MS 599. ACCEPTABLE ORIGINAL EVIDENCE WAS FOUND FOR ALL CORNERS AS INDICATED ON THE PLAT AND THE CORNERS WERE REMONUMENTED AS NOTED. THE BOUNDARIES BETWEEN NATIONAL FOREST AND PRIVATE LAND WERE POSTED TO FOREST SERVICE STANDARD. WM ELMER DID FINE WORK ON THIS SURVEY CONSIDERING THE CLIFFS AND RIDGES EXISTING ON THE NORTHERLY END OF MAIDEN'S DREAM AND THE EQUIPMENT AVAILABLE IN 1905. OUR SURVEY WAS PERFORMED WITH ONE-SECOND THEODOLITE AND INFA-RED DISTANCE MEASURING EQUIPMENT.

NOTES

FOR ADDITIONAL INFORMATION ON CORNERS REMONUMENTED, SEE FORMS R6-7100-57.

FIELD BOOK REFERENCE - TRAVERSE BOOK #3 AND MONUMENTATION BOOKS #2 & 3 OF THE BALD IBEX CADASTRAL SURVEY.

SURVEYOR'S CERTIFICATION

I, WILLIAM R. WELLS, A REGISTERED PROFESSIONAL LAND SURVEYOR IN THE STATE OF OREGON, DO HEREBY CERTIFY, THAT THIS PLAT, AND THE NOTES HERON, OR ATTACHED, ARE A CORRECT REPRESENTATION OF A SURVEY PERFORMED BY ME DURING THE MONTH OF SEPTEMBER, 1985, AT THE REQUEST OF THE USDA, FOREST SERVICE. SAID PLAT AND NOTES WERE PREPARED IN ACCORDANCE WITH THE STATUTES OF THE STATE OF OREGON AND WITH THE ARTICLES OF THE CONTRACT.

William R. Wells

WILLIAM R. WELLS, PLS
 OREGON LICENSE NO. 1106.

REGISTERED PROFESSIONAL LAND SURVEYOR

William R. Wells
 OREGON
 JULY 22, 1977
 WILLIAM R. WELLS
 1106

RECEIVED AND FILED

JAN 8 1986

OFFICE OF COUNTY SURVEYOR
Robert M. August
 Attest: *John W. ...*

WILLIAM R. WELLS, PLS LAND SURVEYING SERVICES P.O. BOX 1696 PENDLETON, OREGON 97801 PHONE: 503 276 6362	PROJECT: BALD IBEX CADASTRAL SURVEY PLAT OF MS 599 SURVEY PERFORMED FOR THE WALLOWA WHITMAN NAT. FOREST CONTRACT NO. 93-0441-9-9780N
Date: 10-27-85 Dr. By: WRW Ck. By: WRW	No: 85-21