



PLAT OF WILSON, 1985 CADASTRAL SURVEY

Sections 2 & 3, T.7S., R.26 E., W.M.

Grant County, Oregon

Morrow County, Oregon

For the U.S. Forest Service - Contract No. 53-04R3-5-1425

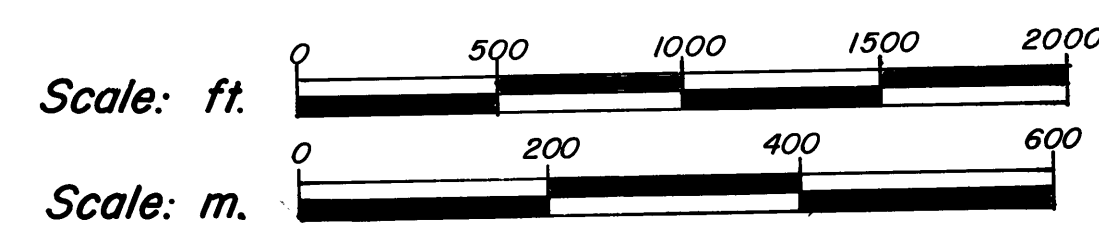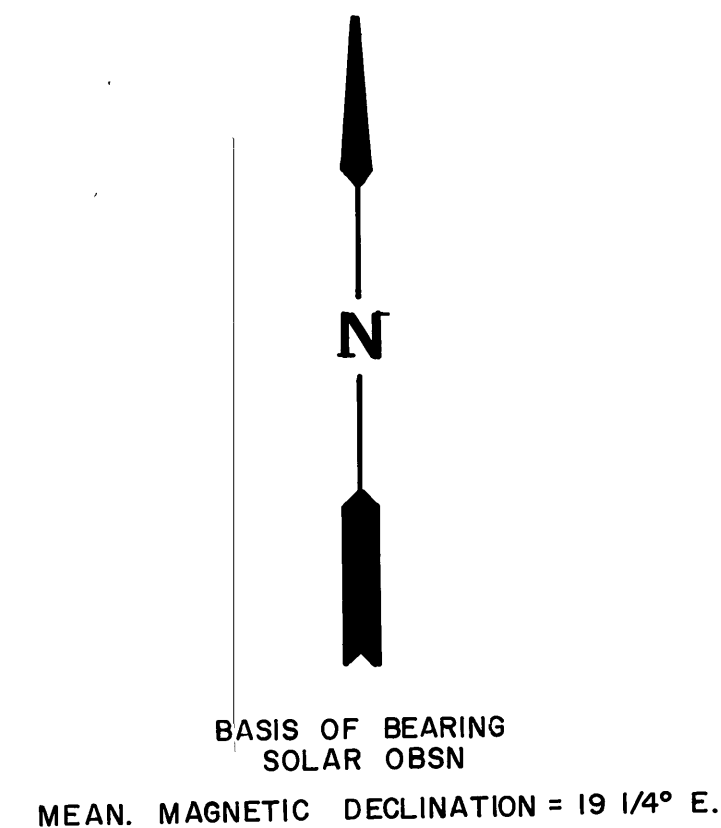

- ⊙ Corner found properly monumented, recorded.
- Monument set this survey from original evidence, certified record filed; 2 1/2" x 30" alum. pipe with 3" alum. cap.
- Monument set this survey from measurement, certified record filed; 2 1/2" x 30" alum. pipe with 3" alum. cap.
- Boundary posted this survey.

HISTORY AND NARRATIVE - Refer to Wilson 1985 Cadastral Survey - Sections 2 & 3, T.7S., R.26 E., W.M.: History and Narrative, filed with this plat.

Contract Surveyor's Certificate


I, Fayette Smith Munro, a Registered Professional Land Surveyor in the State of Oregon, hereby certify that this plat and the History and Narrative herein referred to are a correct representation of a survey performed by me or under my direction during June through November, 1985 at the request of the U.S.D.A. Forest Service, in accordance with the statutes of the State of Oregon and the articles of my contract.

Fayette Smith Munro

Fayette Smith Munro

Registered Professional Land Surveyor

Oregon License No. 1832

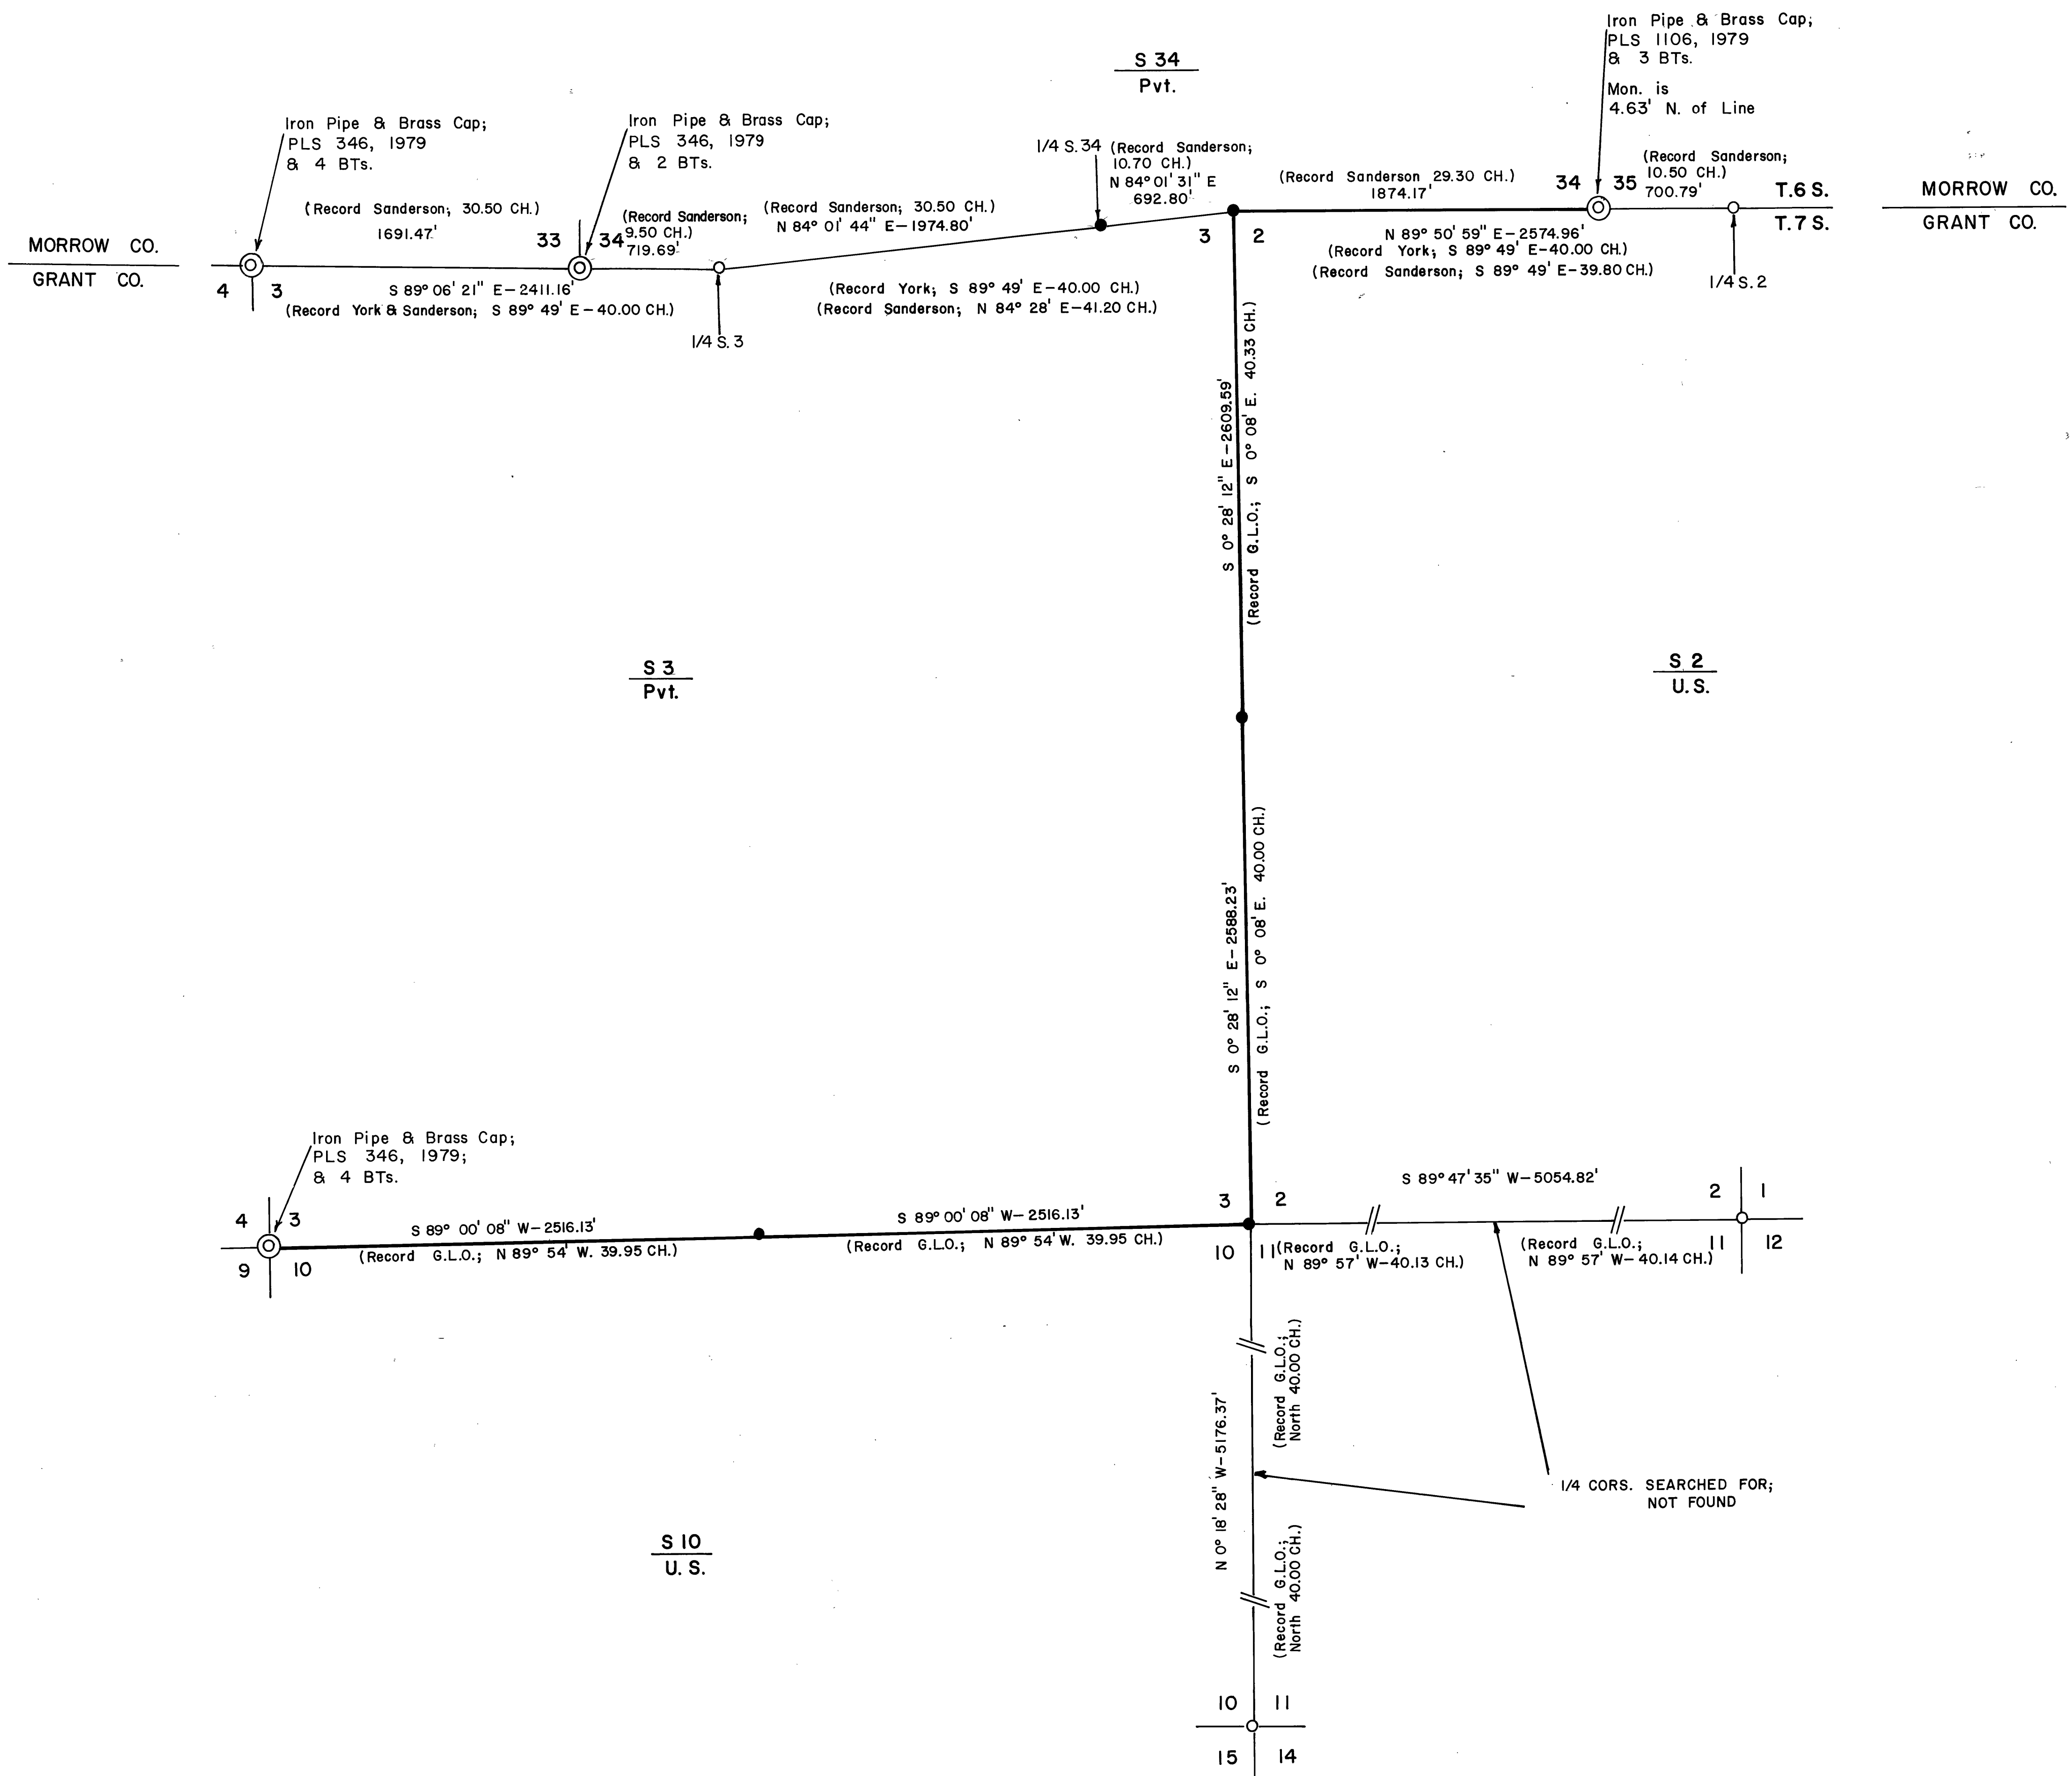

RECEIVED AND FILED

JAN 10 1986

OFFICE OF COUNTY SURVEYOR
Attest: *[Signature]*