


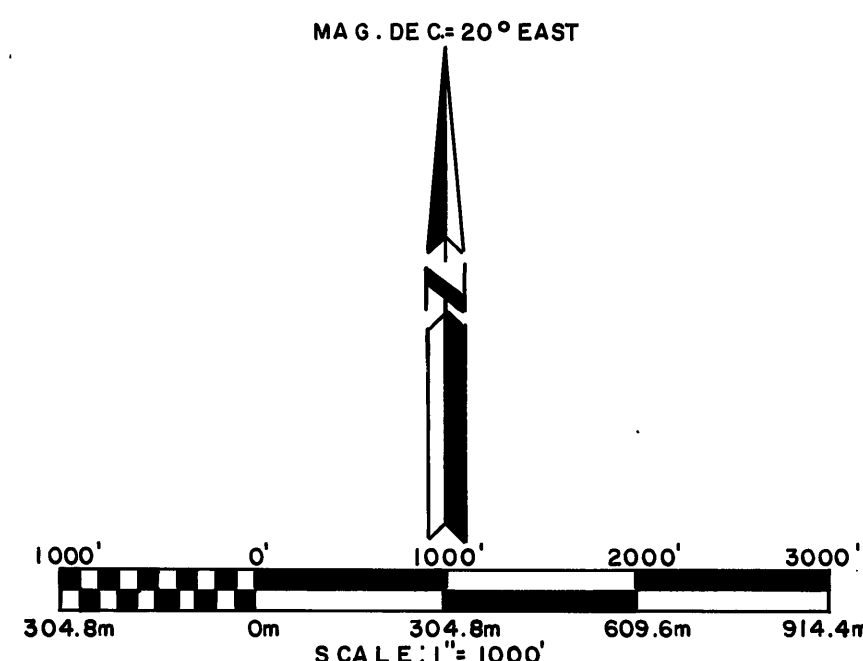


BASIS OF BEARINGS

SOLAR OBSERVATIONS, WITH THE TRUE MERIDIAN
THROUGH THE N-S CENTERLINE OF SECTIONS
11, 14, 23, & 26.

LEGEND

- Set 2-1/2"x30" aluminum pipe with 3-1/2" aluminum cap, stamped as shown on 'MONUMENTATION' hereon.
- Found 2-1/2" aluminum pipe with 3-1/2" aluminum cap, stamped as shown on the Map below, (See HISTORY on Sheet 1)
- Forest Boundary, marked by setting steel posts with Boundary Signs, at approx. max. intervals of 200'
- () Bearing or Distance of Record, as reported by the original, General Land Office Survey. (See HISTORY, on Sheet 1.)
- [] Record Bearing or Distance as reported on Map of Survey No. 698, by David B. Armstrong, of Prineville Oregon.
- Fence line of significant encroachment.
- Old down, fence line

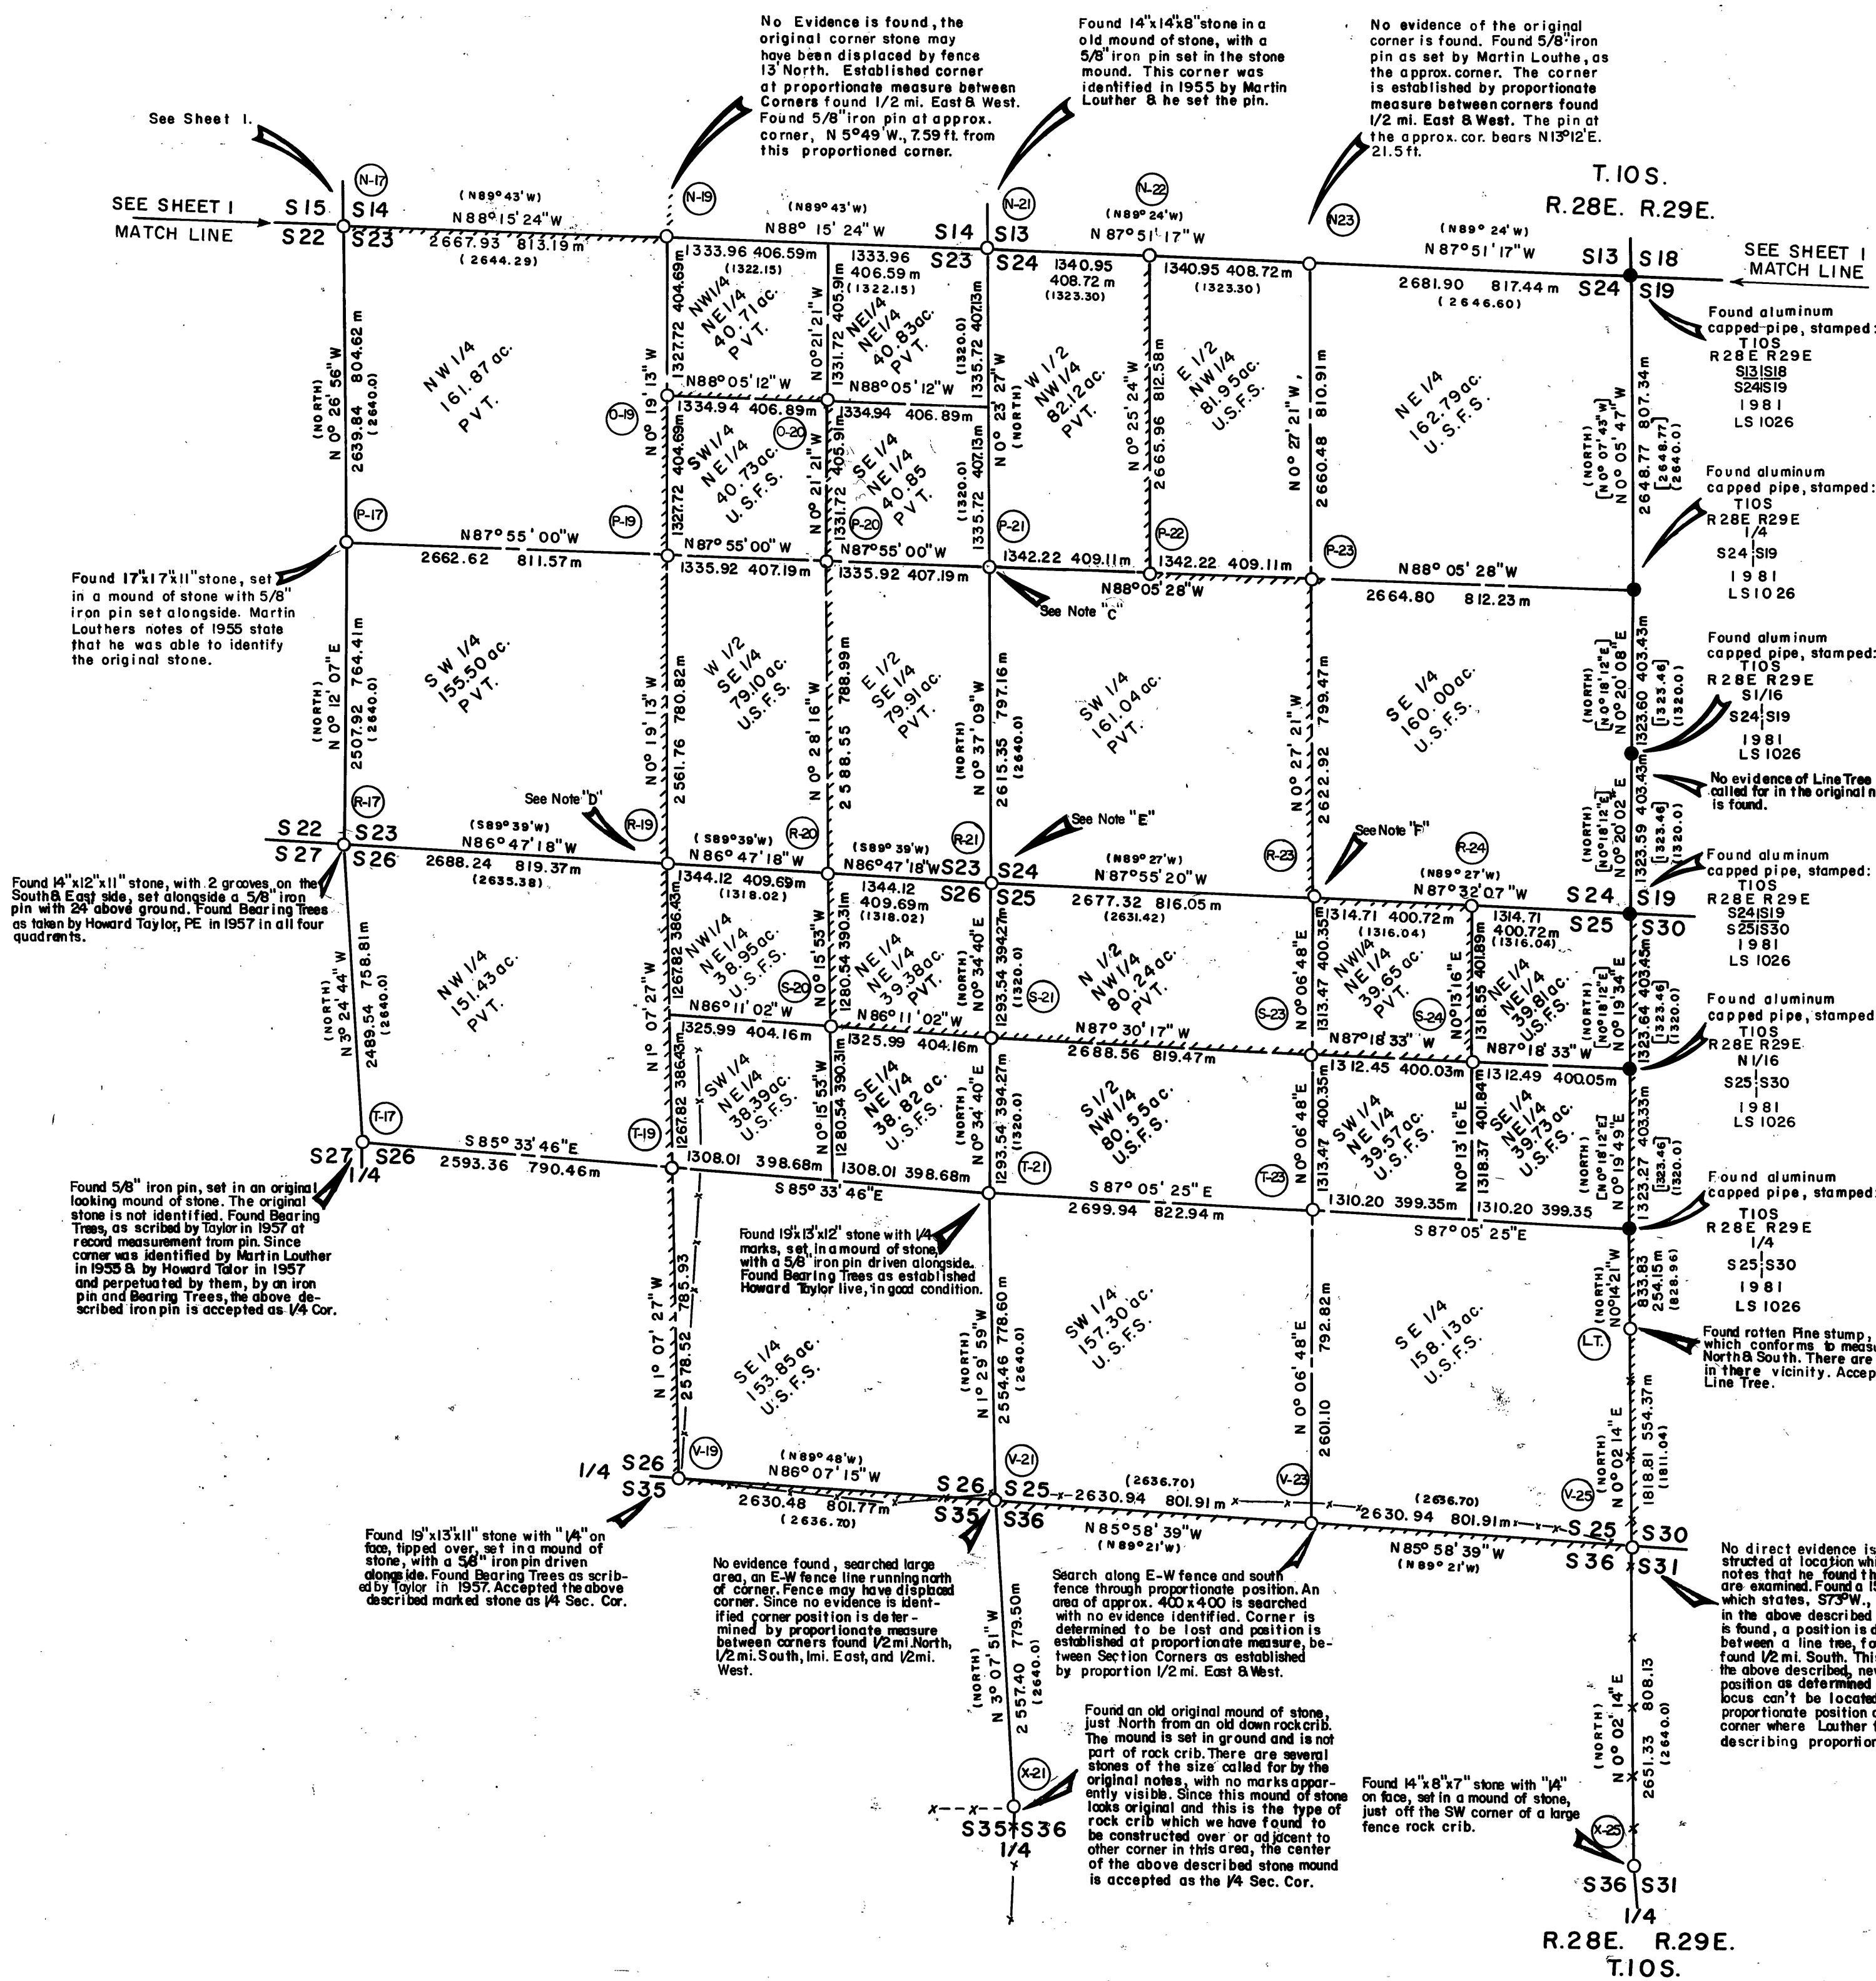

R.28E. R.29E.
T.10S.

MONUMENTATION

CONTINUED FROM SHEET 1, (See "MONUMENTATION")

- | | |
|---|---|
|---|---|

RECEIVED AND
FILED

JUN 20 1985

CLERK OF COUNTY SHERIFF
Douglas M. Ferguson
848

REGISTERED
PROFESSIONAL
LAND SURVEYOR
OREGON
DOUGLAS M. FERGUSON
848