


PORTLAND PRECISION INSTRUMENT & REPAIR CO.

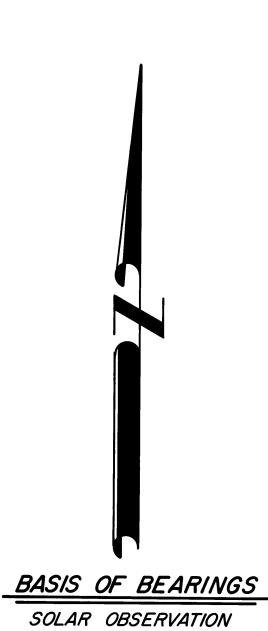

• Found monument as shown

<u>LEGEND</u>

- Set 5/8" x 30" iron pin with attached yellow plastic cap marked B·G·A SURVEY MARKER.
- x x Fence line
- () Record bearing and distance

REFERENCES

Deed Record Book 127 Page 182 Record Map of Survey No. 163 & 244

NARRATIVE: This survey was performed at the request of Ralph Goodwin, acting in behalf of the Grant County Federal Credit Union to delineate the tract of land shown hereon, described in Book 127, Page 182 Deeds.

A search was made of the available records pertaining to this survey. Field measurements were made to locate existing monuments. New monuments set in accordance with the evidence shown and by utilizing the deed records. I found no unusual conditions with this survey.

received and FILED



BAGETT - GRIFFITH & ASSOCIATES

John Day, Oregon

MAP OF SURVEY SITUATED IN THE SEI/4SEI/4 SECTION 22 TI3S,R3IE,W.M. CITY OF JOHN DAY GRANTCOUNTY, OREGON

SURVEYED FOR GRANT CO. FEDERAL CREDIT UNION R.D.B. & J.L.W. SURVEYED BY 2/24/86 Scale: /"=20 Drawn by: J.L.W.