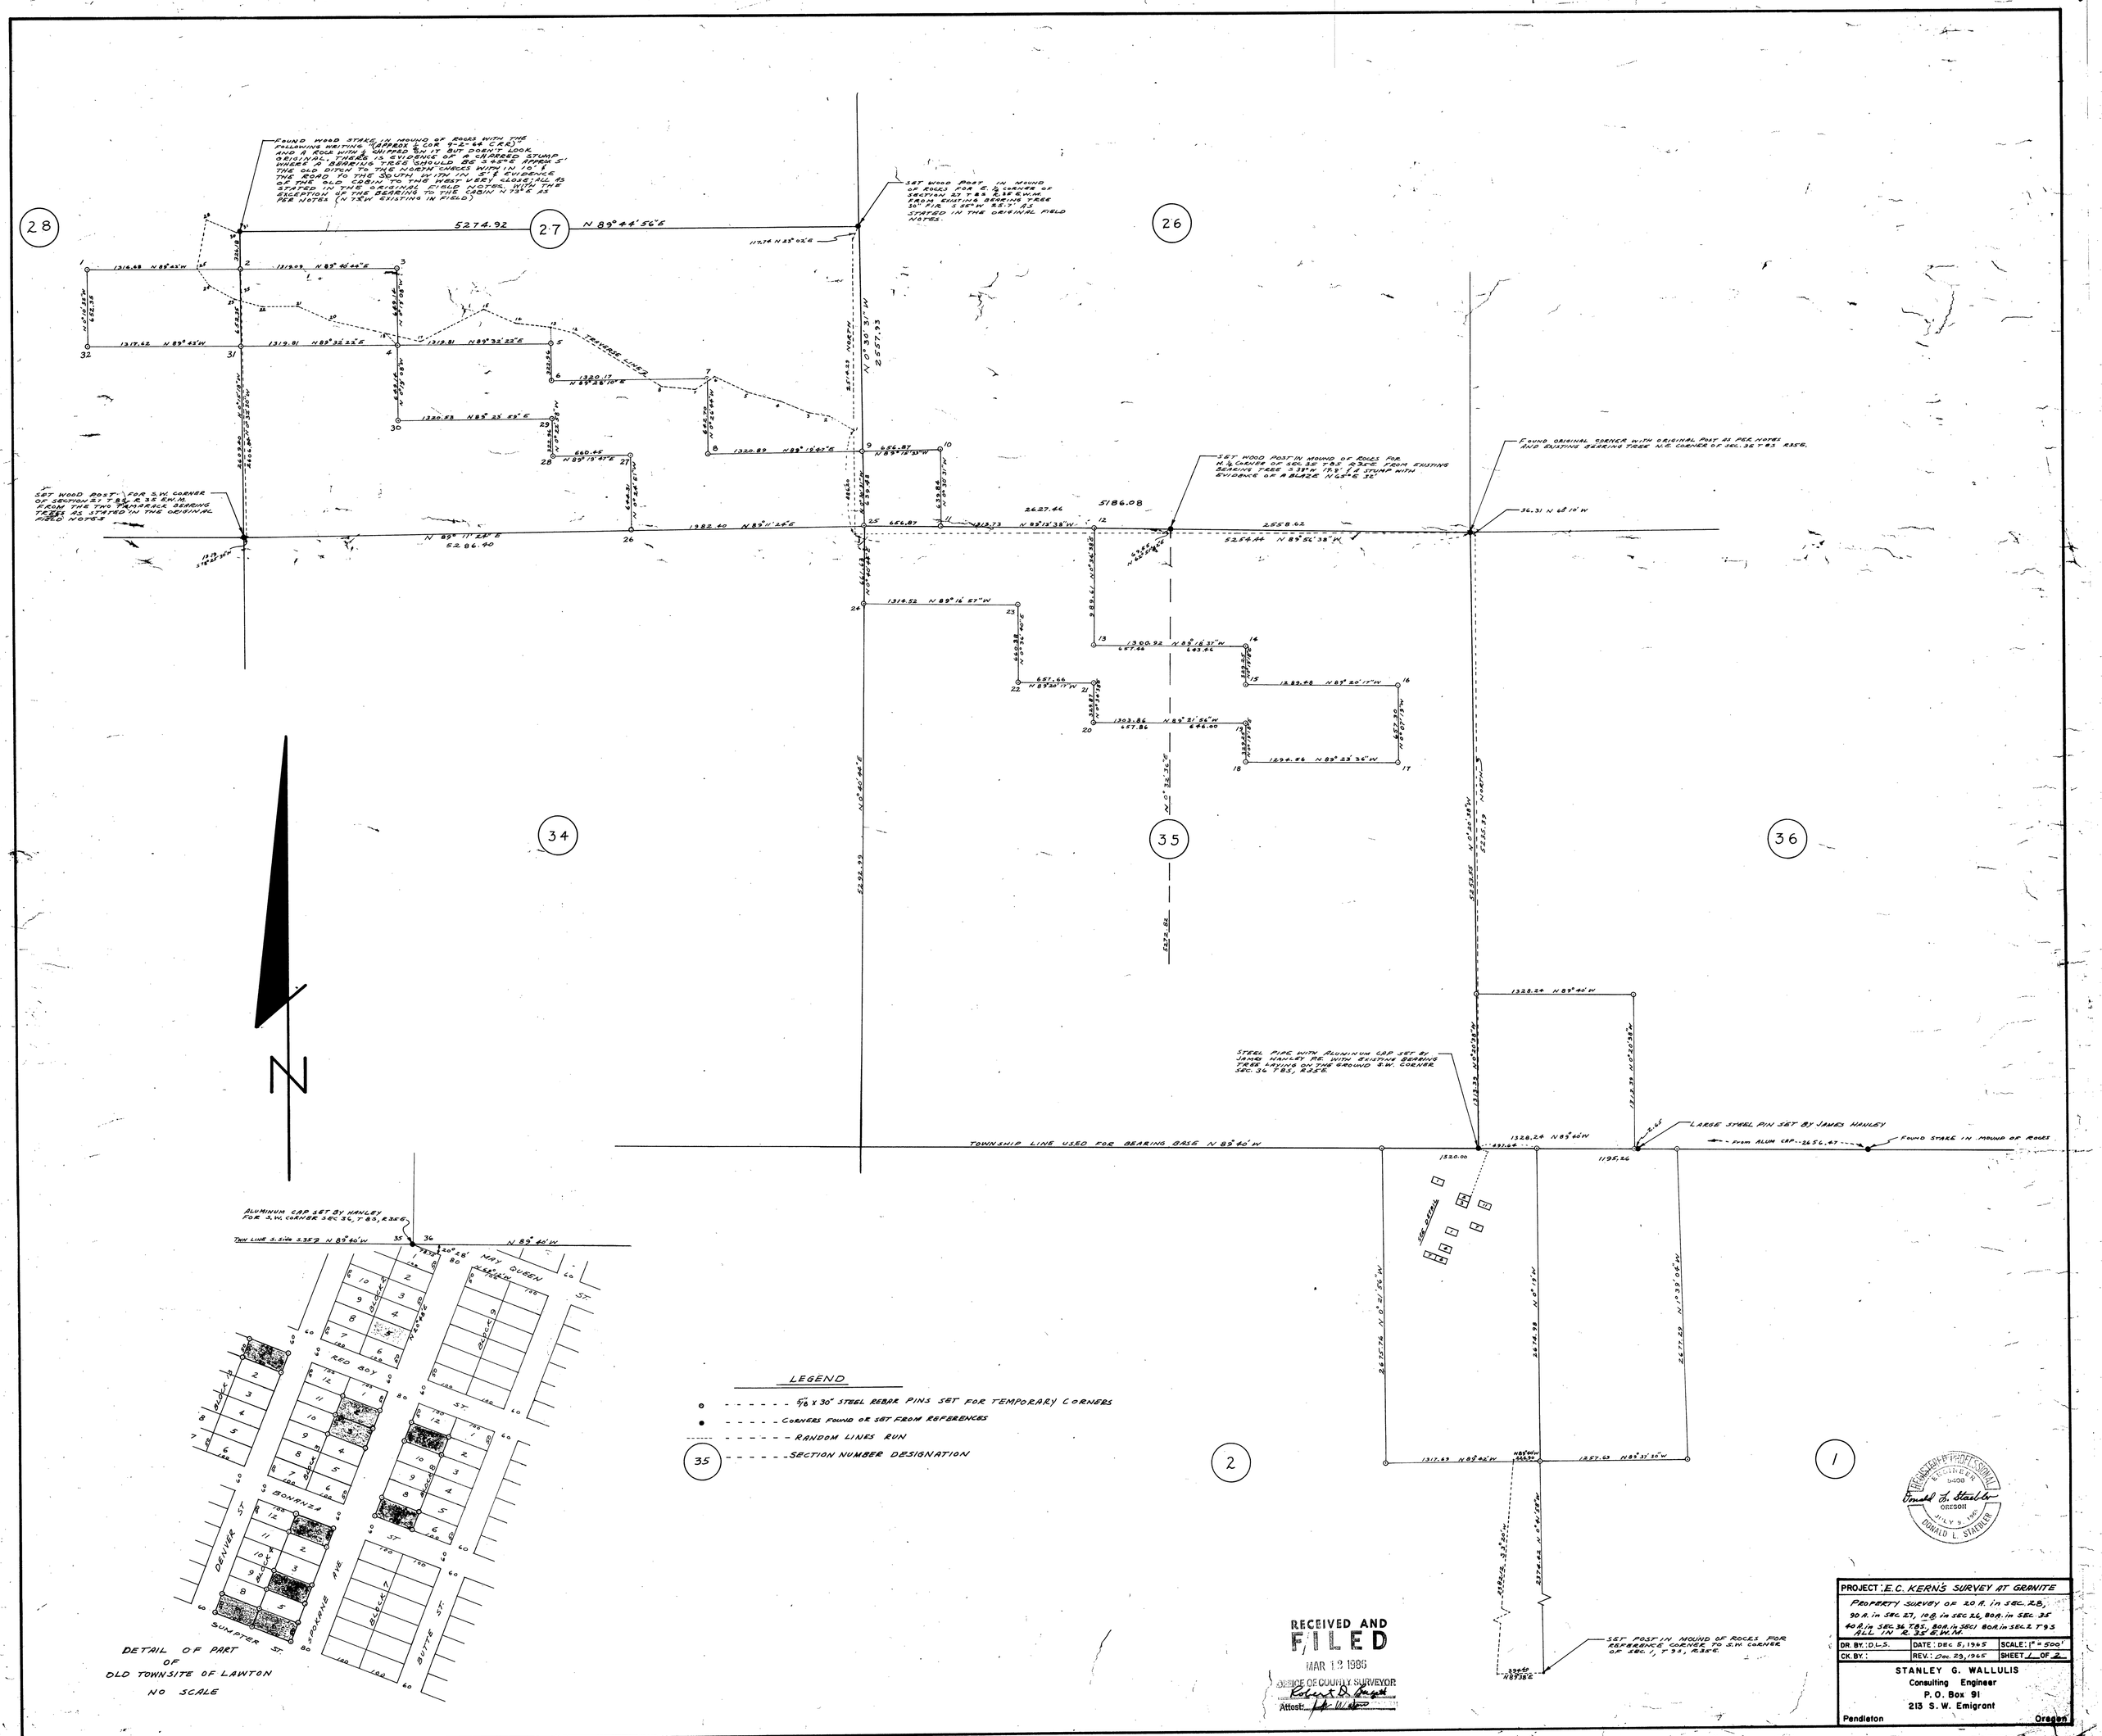
FOUND WOOD STAKE IN MOUND OF ROCKS WITH THE FOLLOWING WRITING "APPROX 1/4 COR 9-2-64 C.E.R." AND A ROW WITH A WHITTLED ON IT BUT DOESN'T LOOK ORIGINAL THERE IS EVIDENCE OF A CHARRED STUMP WHERE A BEARING TREE SHOULD BE 3.42'E ARROW 5' THE OLD DITCH TO THE NORTH CHECKS WITHIN 10'. THE ROAD TO THE SOUTH WITH IN 5'. EVIDENCE OF THE OLD CABIN TO THE WEST VERY CLOSE ALL AS STATED IN THE ORIGINAL FIELD NOTES, WITH THE EXCEPTION OF THE BEARING TO THE CABIN N 13°E AS PER NOTES (N 73°W EXISTING IN FIELD)
LARGE STEEL PIN SET BY JAMES HANLEY
FOUND STAKE IN MOUND OF ROCKS
TOWNSHIP LINE USED FOR BEARING BASE N 89° 40' W
TRAVERSE LINES
TWN LINE S. 3/4 M. S. 33'9 N 89° 40' W
N 89° 40' W
MAY QUEEN
RED BOY
BONANZA
DENVER ST
SPOKANE AVE
SUMPTER ST
BUTTE ST
BLOCK 8
BLOCK 9
BLOCK 7
BLOCK 4
BLOCK 3
BLOCK 2
BLOCK 1
DETAIL OF PART OF OLD TOWNSITE OF LAWTON NO SCALE
LEGEND
5/8 x 30" STEEL REBAR PINS SET FOR TEMPORARY CORNERS
CORNERS FOUND OR SET FROM REFERENCES
RANDOM LINES RUN
SECTION NUMBER DESIGNATION
RECEIVED AND FILED
MAR 12 1986
OFFICE OF COUNTY SURVEYOR
Attest:
REGISTERED PROFESSIONAL ENGINEER
OREGON
JULY 9, 1965
DONALD L. STAEBLER
PROJECT: E.C. KERN'S SURVEY AT GRANITE
DR. BY: D.L.S.
DATE: DEC 5, 1965
SCALE: 1" = 500'
CK. BY:
REV.: Dec. 29, 1965
SHEET 1 OF 2
STANLEY G. WALLULIS
Consulting Engineer
P.O. Box 91
213 S.W. Emigrant
Pendleton
Oregon
MAP OF SURVEY NO. 924