


RECEIVED AND

APR 101986

PORTLAND PRECISION INSTRUMENT

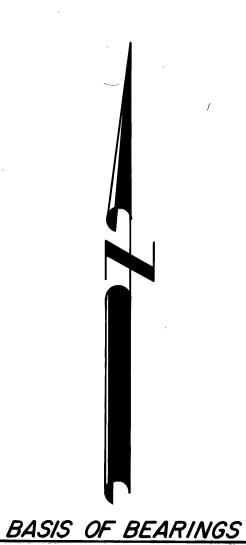

LEGEND

SOLAR OBSERVATION

- Found brass cap monument of record
- Found 5/8" iron pin of record
- Found 1/2" iron pin of record
- Set 5/8"x 30" iron pin with attached yellow plastic cap marked B-G-A SURVEY MARKER.
- () Plat record bearing and distance

REFERENCES

Plat of Hall Acres Subdivision
Record Map of Survey No. 177

BAGETT - GRIFFITH & ASSOCIATES

John Day, Oregon

MAP OF SURVEY
A PORTION OF LOT I, BLK I & DOROTHY DRIVE
A PORTION OF LOTS 9 & 10, BLOCK 2
HALL ACRES SUBDIVISION

SURVEYED FOR RICHARD ZICKLER

 SURVEYED BY
 R.D.B. & J.L.W.
 3/12/86

 Scale: /"=50'
 Drawn by: J.L.W.
 3/13/86