


NOTE
Bearings based on northerly
street line of Mountain View
Drive.

- LEGEND
- Fd. Monuments
 - o Set 3/4" Iron Pipe

REGISTERED
OREGON
LAND SURVEYOR

Duane I. Griffith
JULY 10, 1964
DUANE I. GRIFFITH
644

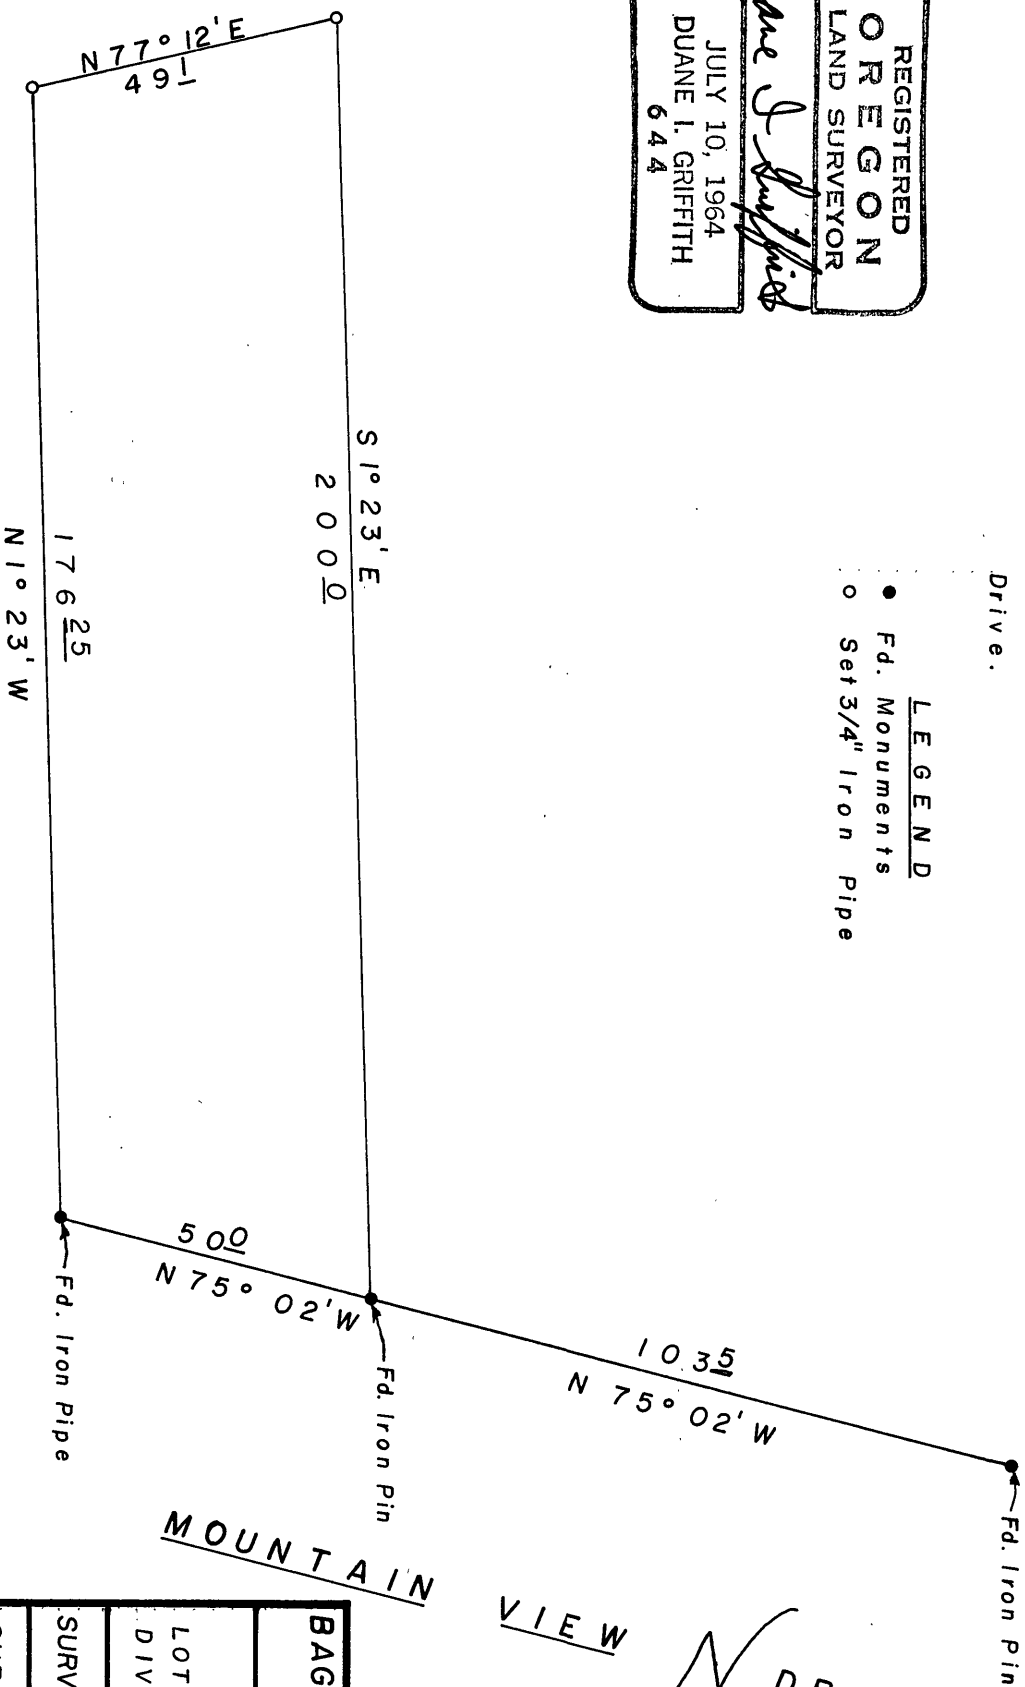

RECEIVED AND
FILED
SEP 12 1967
JOHN LIVERNA, County Clerk
By _____ Deputy

BAGETT & GRIFFITH SURVEYING			
JOHN DAY, OREGON			
MAP OF SURVEY			
LOT 10, BLK. D, OF THE TROWBRIDGE SUB-DIVISION, JOHN DAY, OREGON.			
SURVEYED FOR	CHARLES TROWBRIDGE		
SURVEYED BY	D. I. GRIFFITH		
SCALE 1"=30'	DRWN BY GDG	9/8/67	