


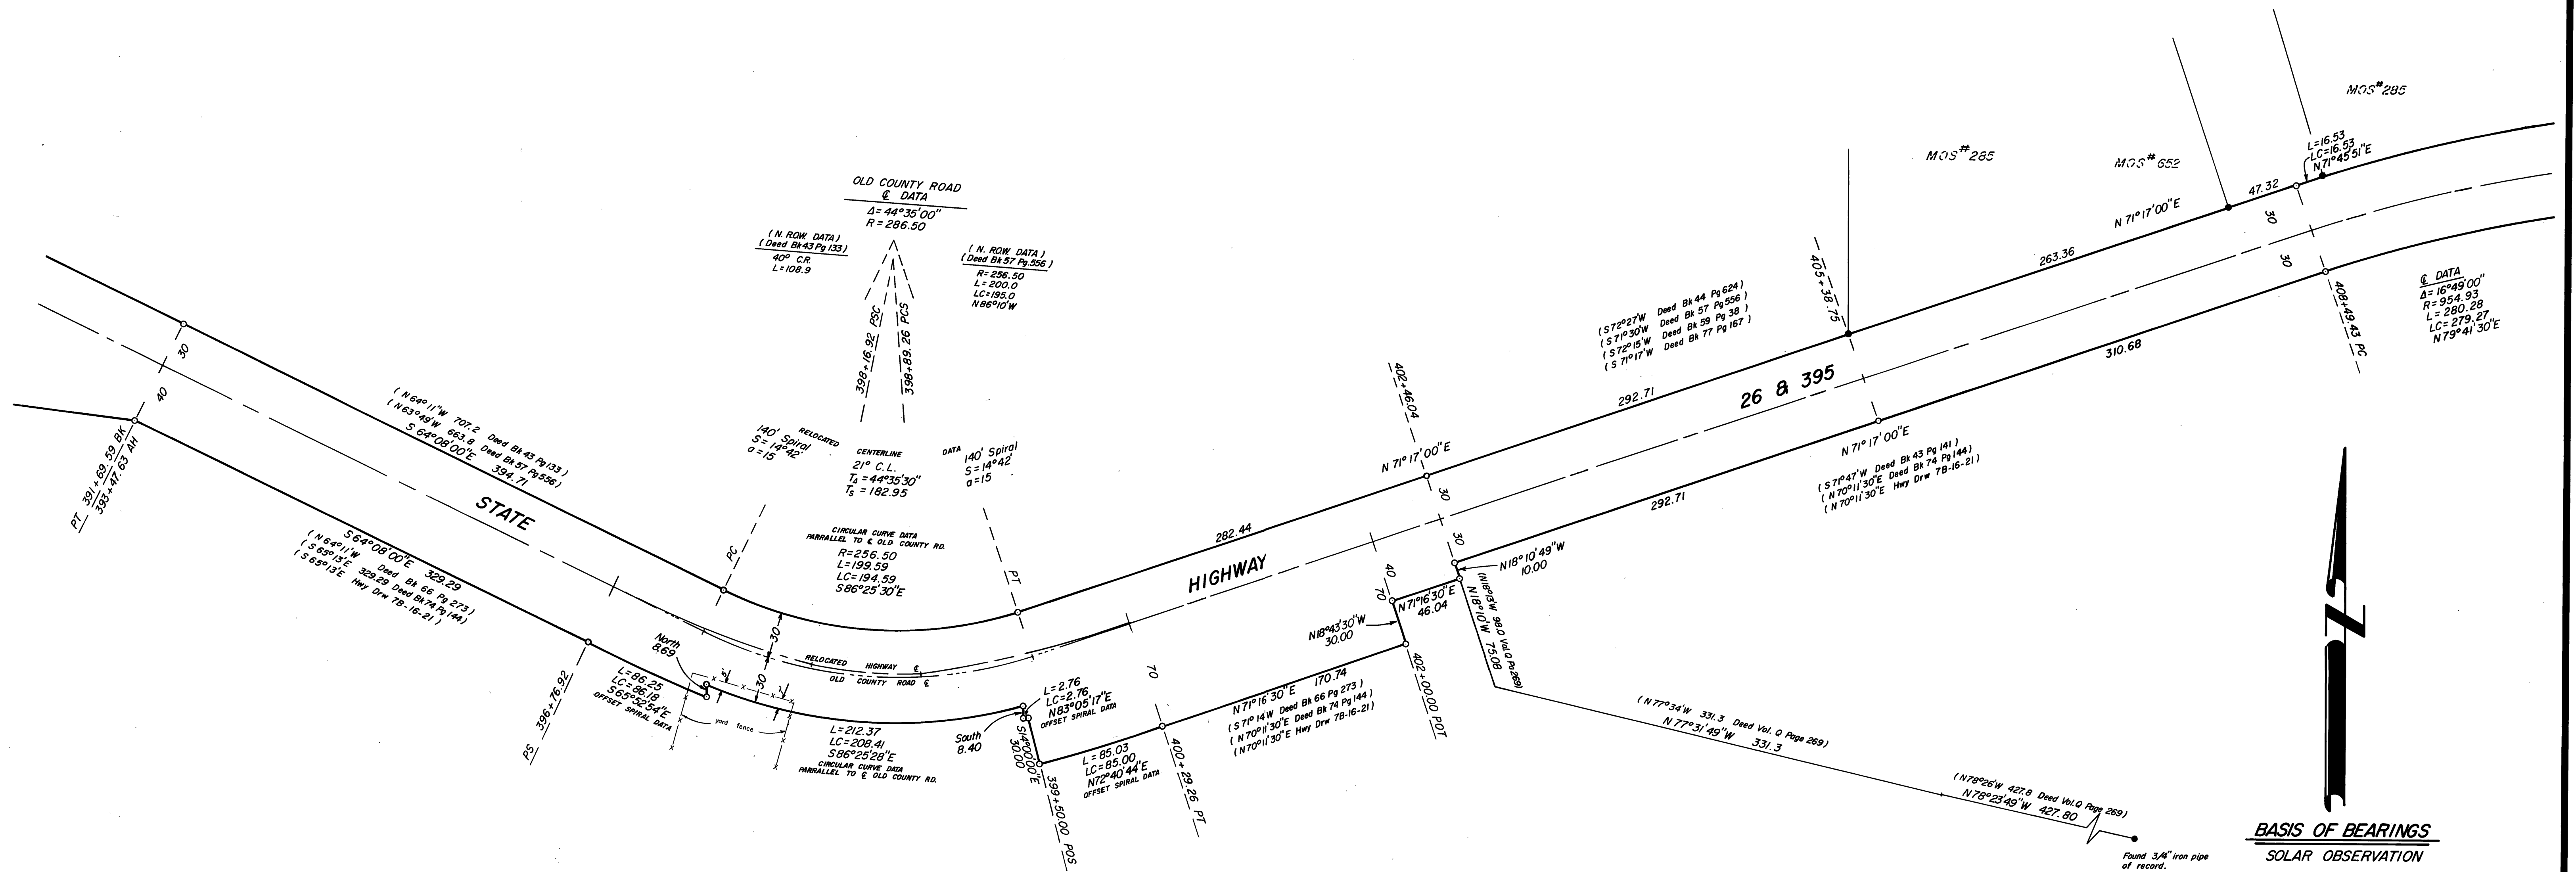

BASIS OF BEARINGS
 SOLAR OBSERVATION

LEGEND

- Found monument as shown
- Found 5/8" iron pin, unless otherwise shown
- Set 5/8"x30" iron pin with attached yellow plastic cap marked B-G-A SURVEY MARKER.
- ✕ Set rail road spike
- () Record bearing and distance
- M.O.S. Record map of survey

SHEET 2 OF 4

RECEIVED AND FILED

MAY 21 1986

OFFICE OF COUNTY SURVEYOR
 Attest: *[Signature]*

REGISTERED PROFESSIONAL LAND SURVEYOR

Robert D. Baggett
 JULY 15, 1983
 ROBERT D. BAGGETT
 598

BAGETT - GRIFFITH & ASSOCIATES John, Bay, Oregon		
MAP OF SURVEY OF A PORTION OF THE RIGHT OF WAY LINES OF STATE HIGHWAY 26 & 395 SITUATED IN SECTIONS 22, 23, & 26, T13S, R31E, W.M.		
GRANT COUNTY, OREGON		
SURVEYED FOR	OREGON STATE HIGHWAY DEPARTMENT	
SURVEYED BY	R.D.B. & J.L.W.	Jan-Apr '86
Scale: 1"=50'	Drawn by: J.L.W.	April '86

RECORD MAP OF SURVEY NO. 932