


TOWNSHIP 10 SOUTH, RANGE 27 EAST, OF THE WILLAMETTE MERIDIAN, OREGON

DEPENDENT RESURVEY AND SUBDIVISION OF SECTIONS

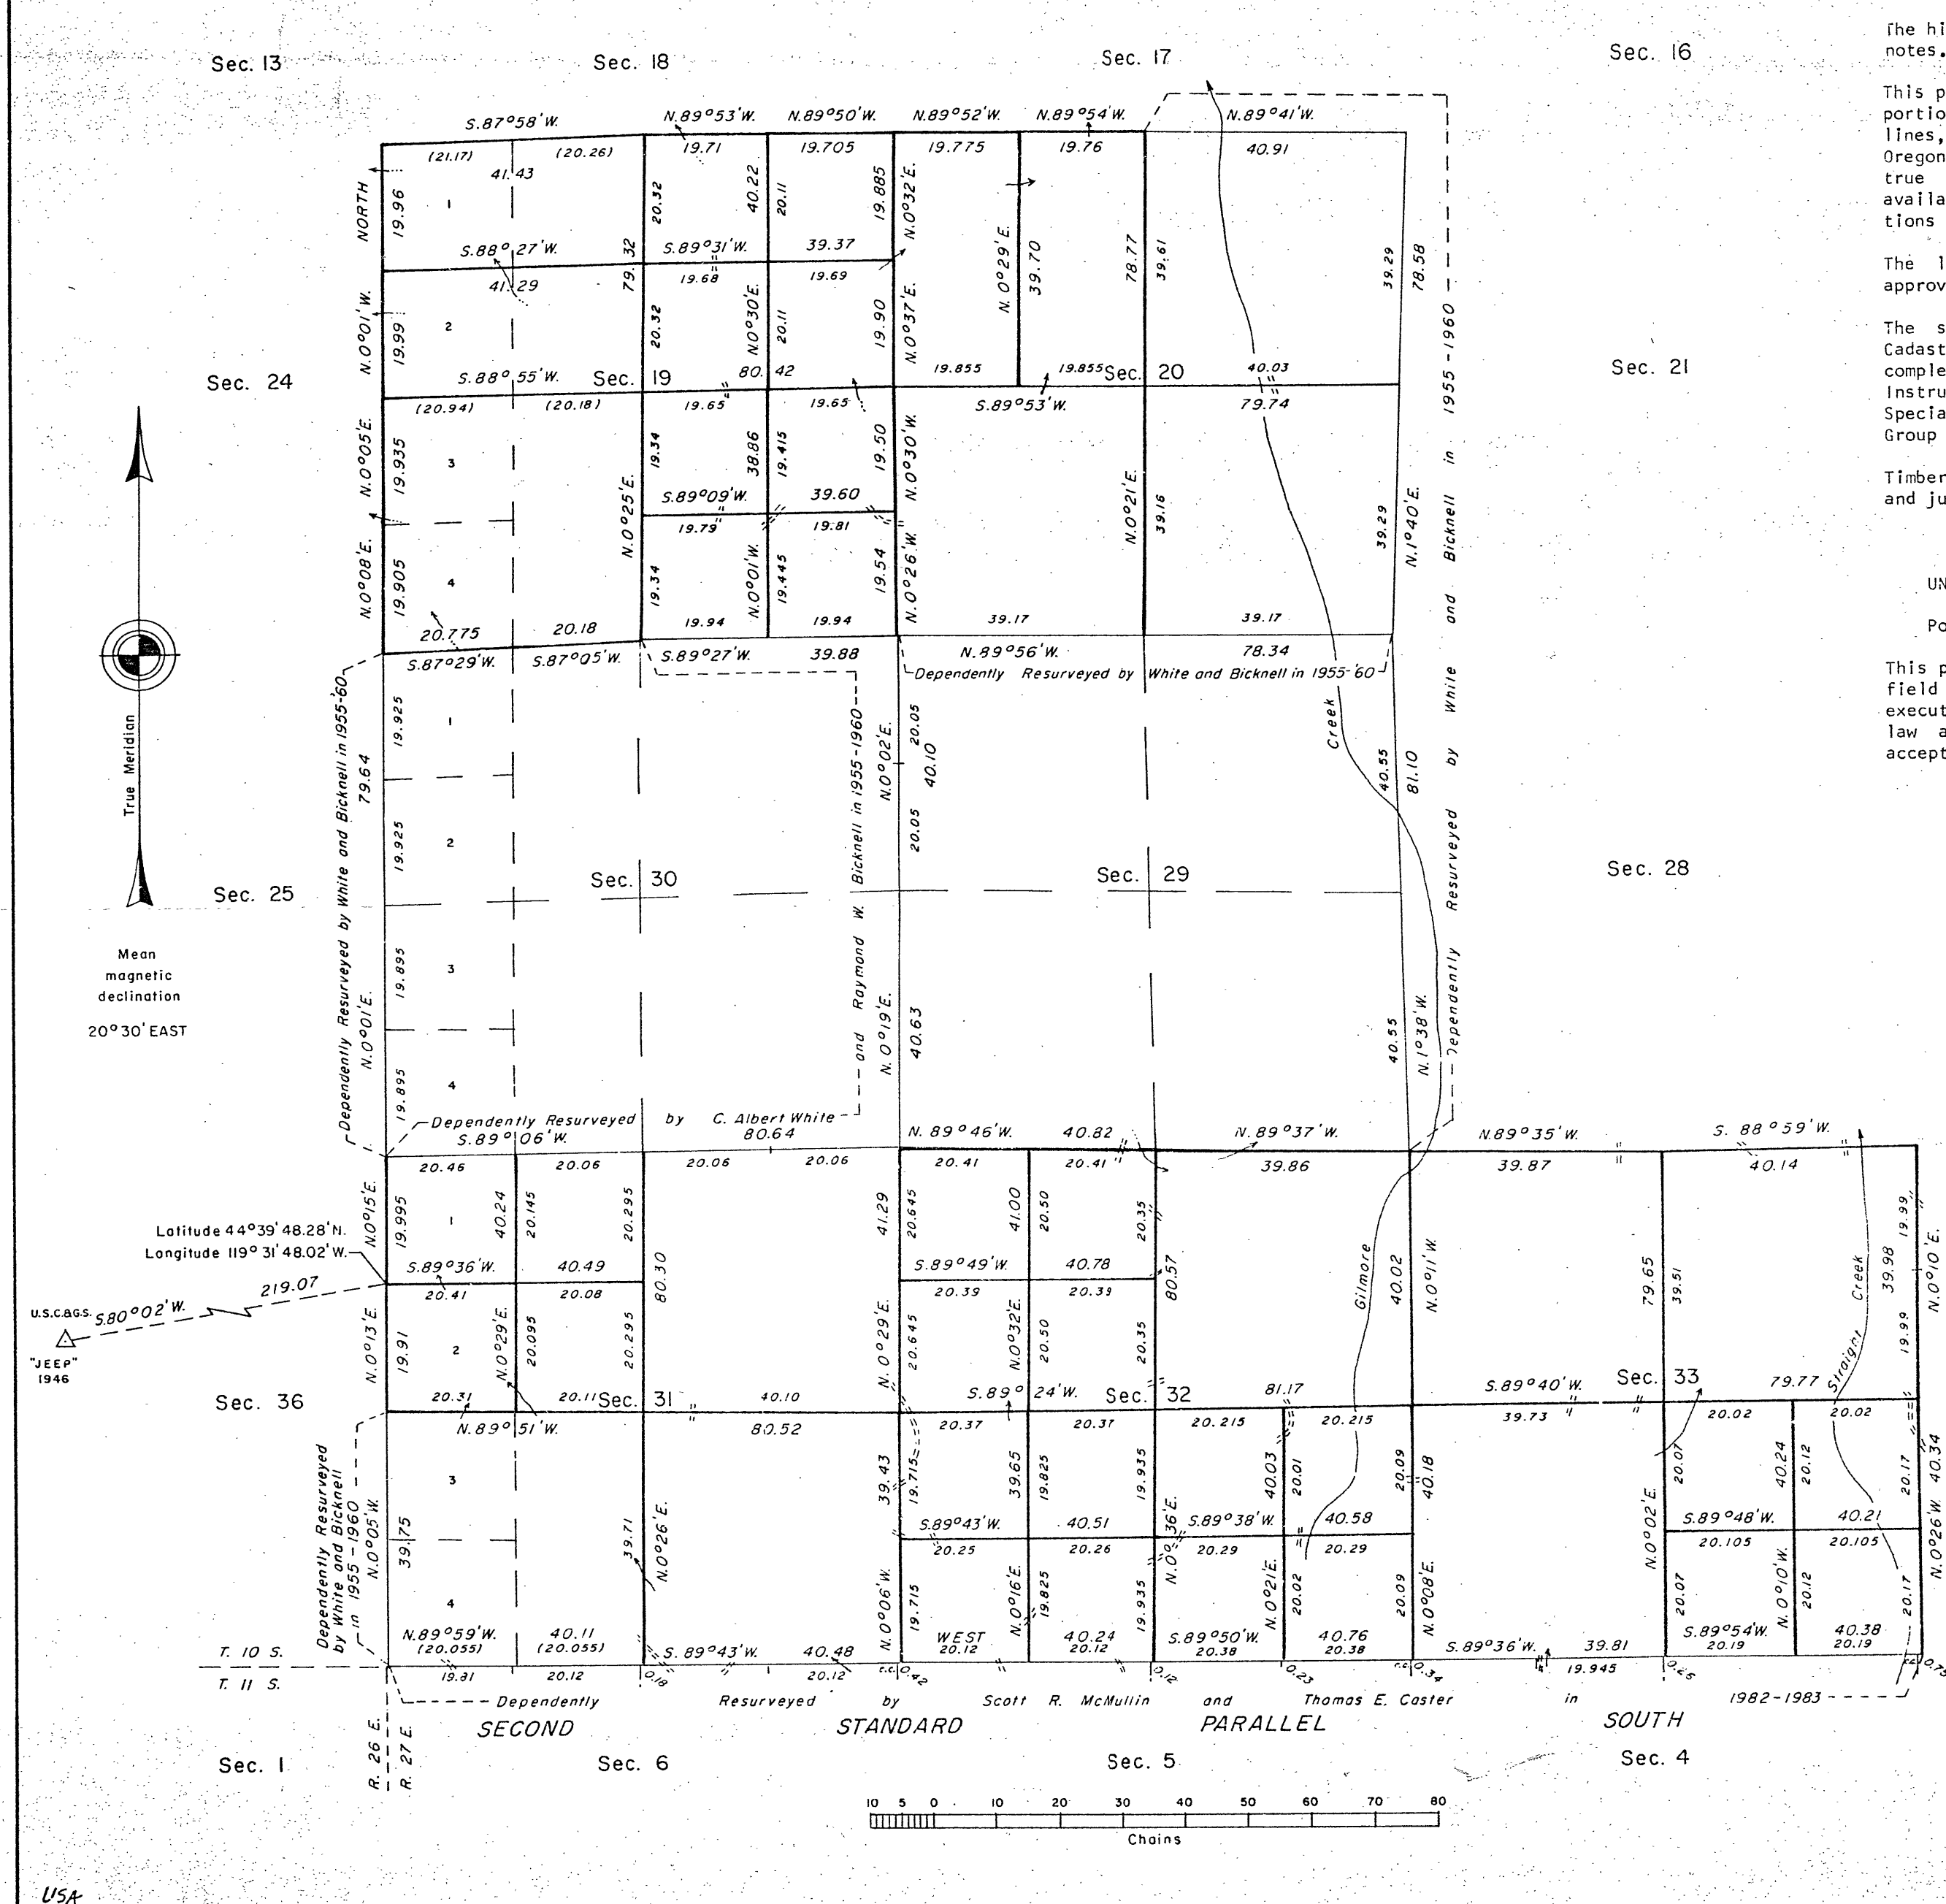

The history of surveys is contained in the field notes.

This plat represents a dependent resurvey of a portion of the west boundary and subdivision lines, T. 10 S., R. 27 E., Willamette Meridian, Oregon, designed to restore the corners in their true original locations according to the best available evidence, and the subdivision of sections 19, 20, 31, 32, and 33.

The lottings and areas are as shown on the plat approved December 19, 1881.

The survey was executed by Thomas E. Caster, Cadastral Surveyor, beginning August 30, 1983, and completed August 29, 1984, pursuant to Special Instructions dated August 12, 1983, and Amended Special Instructions dated May 17, 1984, under Group Number 1174, Oregon.

Timber in this area consists of fir, pine, larch, and juniper.

UNITED STATES DEPARTMENT OF THE INTERIOR
BUREAU OF LAND MANAGEMENT
Portland, Oregon April 4, 1986

This plat is strictly conformable to the approved field notes, and the survey, having been correctly executed in accordance with the requirements of law and the regulations of this Bureau, is hereby accepted.

For the Director

William W. Glenn
Chief Cadastral Surveyor of Oregon

RECEIVED AND
FILED

JUN 6 1986

OFFICE OF COUNTY SURVEYOR

Attest:

FIELD NOTES ON MICROFKHE