

BASIS OF BEARINGS
SOLAR OBSERVATION
Mean Declination 18° 30' E


LEGEND

- Set 1-1/2" x 30" galv. iron pipe with attached Grant County Surveyor Brass Cap, from original corner evidence.
- ⊙ Set 2-1/2" x 30" aluminum pipe with attached aluminum cap.
- () GLO record bearing and distance
- Posted property boundary with 6 foot steel fence posts with attached property boundary signs.



REFERENCES

Deed Record Book 132 Page 225
GLO notes

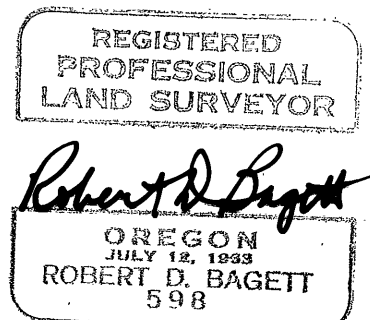

CERTIFICATION:

I, Robert D. Bagett, Land Surveyor registered in accordance with the laws of the State of Oregon, do hereby certify that this plat and notes attached, are a correct representation of a survey I performed during May, 1986 for the Holliday Family Ranches and the U.S. Forest Service in accordance with the statutes of the State of Oregon.

Robert D. Bagett
Robert D. Bagett, OPLS 598

NARRATIVE: This survey was performed at the request of Clyde Holliday on behalf of the Holliday Family Ranches and by Elmo Calkins, acting in behalf of the Malheur National Forest. The purpose of this survey was to locate and mark the boundary lines between private and national forest in section 34, T15S, R31E, W.M. A search was made of the available records pertaining to this survey. Field measurements were made to locate existing monuments and corner evidence. Original corner evidence was found at all the controlling section and 1/4 corners except the east 1/4 corner. No acceptable corner evidence was found at the E 1/4 corner. I established this 1/4 corner at single proportionate measure between the found NE corner of the section and the existing line tree 467 feet south of the E 1/4 corner. This position fits the original call to the creek lying at record 30 links south of 1/4 corner. The third standard parallel south was originally surveyed by A.O. Ecclson, U.S. Deputy Surveyor in 1880 under contract no. 328, dated June 20, 1879. The subdivisional lines of T15S, R31E, were surveyed by Bamford Robb, U.S. Deputy Surveyor, in 1880 under Contract No. 357, dated July 2, 1880. I found no subsequent surveys or remonumentation of record concerning this section. I found no unusual conditions with this survey. For a detailed explanation of corner evidence found, new corners set, and bearing tree information see corner restoration sheets filed in Corner Restoration Book.

RECEIVED AND
FILED

JUN 20 1986
OFFICE OF COUNTY CLERK
J. W. Adams

CORNER ACCESSORIES

- V-13** NW Section Cor.
A 8" P. Pine brs N 2° E, 11.8 ft.
A 8" P. Pine brs S 72° E, 85.8 ft.
A 12" P. Pine brs N 15° W, 77.6 ft.
- V-15** N 1/4 cor.
A 16" P. Pine brs S 49° W, 19.0 ft.
A 8" P. Pine brs N 24° W, 43.3 ft.
- V-17** NE Section Cor.
A 6" P. Pine brs N 83° E, 26.6 ft.
A 8" P. Pine brs S 32° E, 55.0 ft.
A 24" P. Pine brs S 60° W, 125 ft. (orig)
A 10" P. Pine brs N 34° W, 139.0 ft.
- W-16** NE 1/16
A 5" P. Pine brs S 40° E, 38.7 ft.
A 8" P. Pine brs S 28° W, 29.5 ft.
- W-17** N 1/16
A 8" P. Pine brs N 51° E, 23.3 ft.
A 15" P. Pine brs N 48° W, 36.5 ft.
- X-13** W 1/4 cor.
A 13" P. Pine brs N 43° E, 31.3 ft.
A 20" P. Pine brs N 40° W, 38.3 ft. (orig)
- X-15** C 1/4 cor.
A 8" P. Pine brs S 38° E, 14.7 ft.
A 10" P. Pine brs S 37° W, 23.6 ft.
- X-16** CE 1/16
A 8" P. Pine brs N 68° E, 24.9 ft.
A 9" P. Pine brs S 38° E, 34.7 ft.
- X-17** E 1/4 cor.
A 21" P. Pine brs N 45° E, 48.6 ft.
A 7" P. Pine brs N 4° W, 77.3 ft.
- Line Tree 34 35
A 2-1/2" alum. reference monument
brs S 32° 05' 15" E, 10.34 ft.
- Y-13** S 1/16
A 10" P. Pine brs N 42° E, 18.3 ft.
A 13" P. Pine brs N 71° W, 18.6 ft.
- Y-15** S 1/16
A 35" P. Pine brs N 40° E, 209.3 ft.
A 8" P. Pine brs N 35° W, 238.8 ft.
- Z-13** SW Section Cor.
A 35" P. Pine brs N 40° E, 38.3 ft. (orig)
A 20" P. Pine brs N 22° W, 45.8 ft. (orig)
- Z-15** S 1/4 cor.
A 8" P. Pine brs N 61° E, 23.5 ft.
A 8" P. Pine brs N 52° W, 41.6 ft.
- Z-16** E 1/16
A 8" P. Pine brs N 27° E, 61.1 ft.
A 6" P. Pine brs N 70° W, 18.4 ft.
- Z-17** SE Section Cor.
A 13" P. Pine brs N 65° E, 51.2 ft.
A 34" P. Pine brs N 70° W, 68.6 ft. (orig)