


PLAT OF WILSON, 1986 CADASTRAL SURVEY

*Subdivision of Section 29, T.7S., R.27E., W.M.
Grant County, Oregon*

For the U.S. Forest Service-Contract No. 53-04R3-5-1425

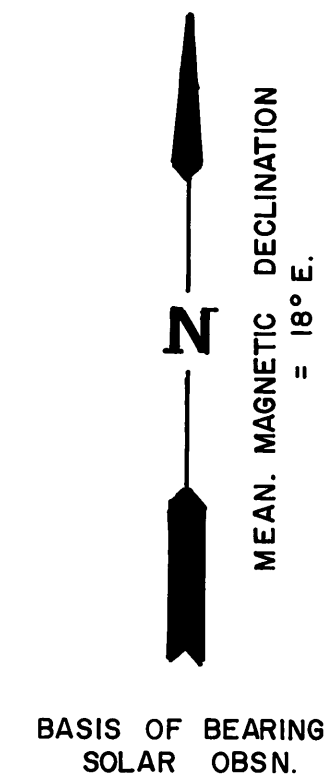

SCALE: FT. 

SCALE: M. 


- (C) Corner found properly monumented, recorded
 (O) Monument set this survey from original evidence; 2 1/2"x 30" alum. pipe with 3" alum. cap; certified record filed.
 (●) Monument set this survey from measurement; 2 1/2"x 30" alum. pipe with 3" alum. cap except as noted; certified record filed
 ————— Subdivision line
 ————— Boundary posted this survey
 x x x Fence encroaching on U.S. ownership

KEY—Subdivision parts not identified elsewhere

<u>DESCRIPTION</u>		<u>OWNER</u>	<u>AREA (ac.)</u>	<u>DESCRIPTION</u>		<u>OWNER</u>	<u>AREA (ac.)</u>
1	SE1/4 SW1/4 SW1/4 NE1/4	Pvt.		7	NE1/4 NE1/4 NE1/4 SW1/4	Pvt.	
2	SW1/4 SW1/4 SW1/4 NE1/4	Pvt.		8	NW1/4 NE1/4 NE1/4 SW1/4	U.S.	2.38
3	NW1/4 SW1/4 SW1/4 NE1/4	Pvt.		9	SW1/4 NE1/4 NE1/4 SW1/4	U.S.	2.38
4	NE1/4 SW1/4 SW1/4 NE1/4	U.S.	2.47	10	SE1/4 NE1/4 NE1/4 SW1/4	U.S.	2.37
5	E1/2 NW1/4 SW1/4 NE1/4	U.S.	4.96	11	NI/2 NE1/4 SE1/4 SE1/4	Pvt.	
6	W1/2 NW1/4 SW1/4 NE1/4	Pvt.		12	SI/2 NE1/4 SE1/4 SE1/4	U.S.	4.83

For complete legal descriptions see HISTORY AND NARRATIVE.

HISTORY AND NARRATIVE: Refer to Wilson 1985 Cadastral Survey - Section 29, T.7S., R.27E., W.M. - History and Narrative filed with this plat.

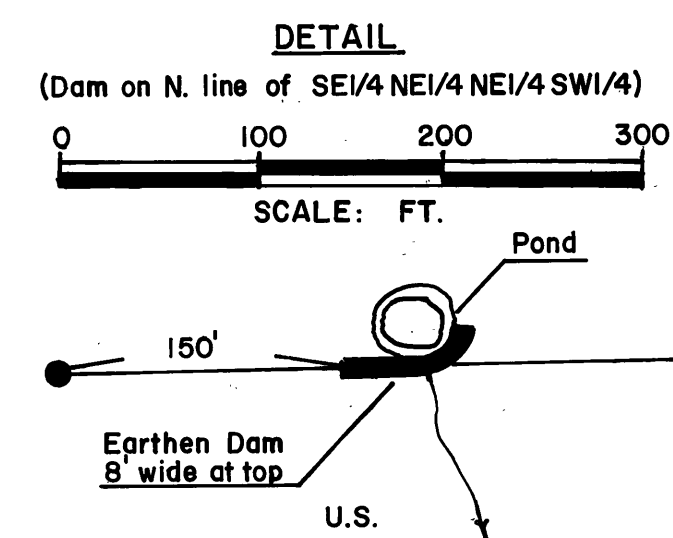

Contract Surveyor's Certificate

I, Fayette Smith Munro, a Registered Professional Land Surveyor in the State of Oregon, hereby certify that this plat and the History and Narrative herein referred to are a correct representation of a survey performed by me or under my direction during September thru November, 1965 and April thru July, 1966 at the request of the U.S.D.A. Forest Service, in accordance with the statutes of the State of Oregon and the articles of my contract.

Fayette S. Munro
Fayette S. Munro

Registered Professional Land Surveyor
Oregon License No. 1832



RECEIVED AND
FILED

JUL 25 1986

OFFICE OF COUNTY SURVEYOR
Robert D. Baggett
Attest: L. L. Waters

