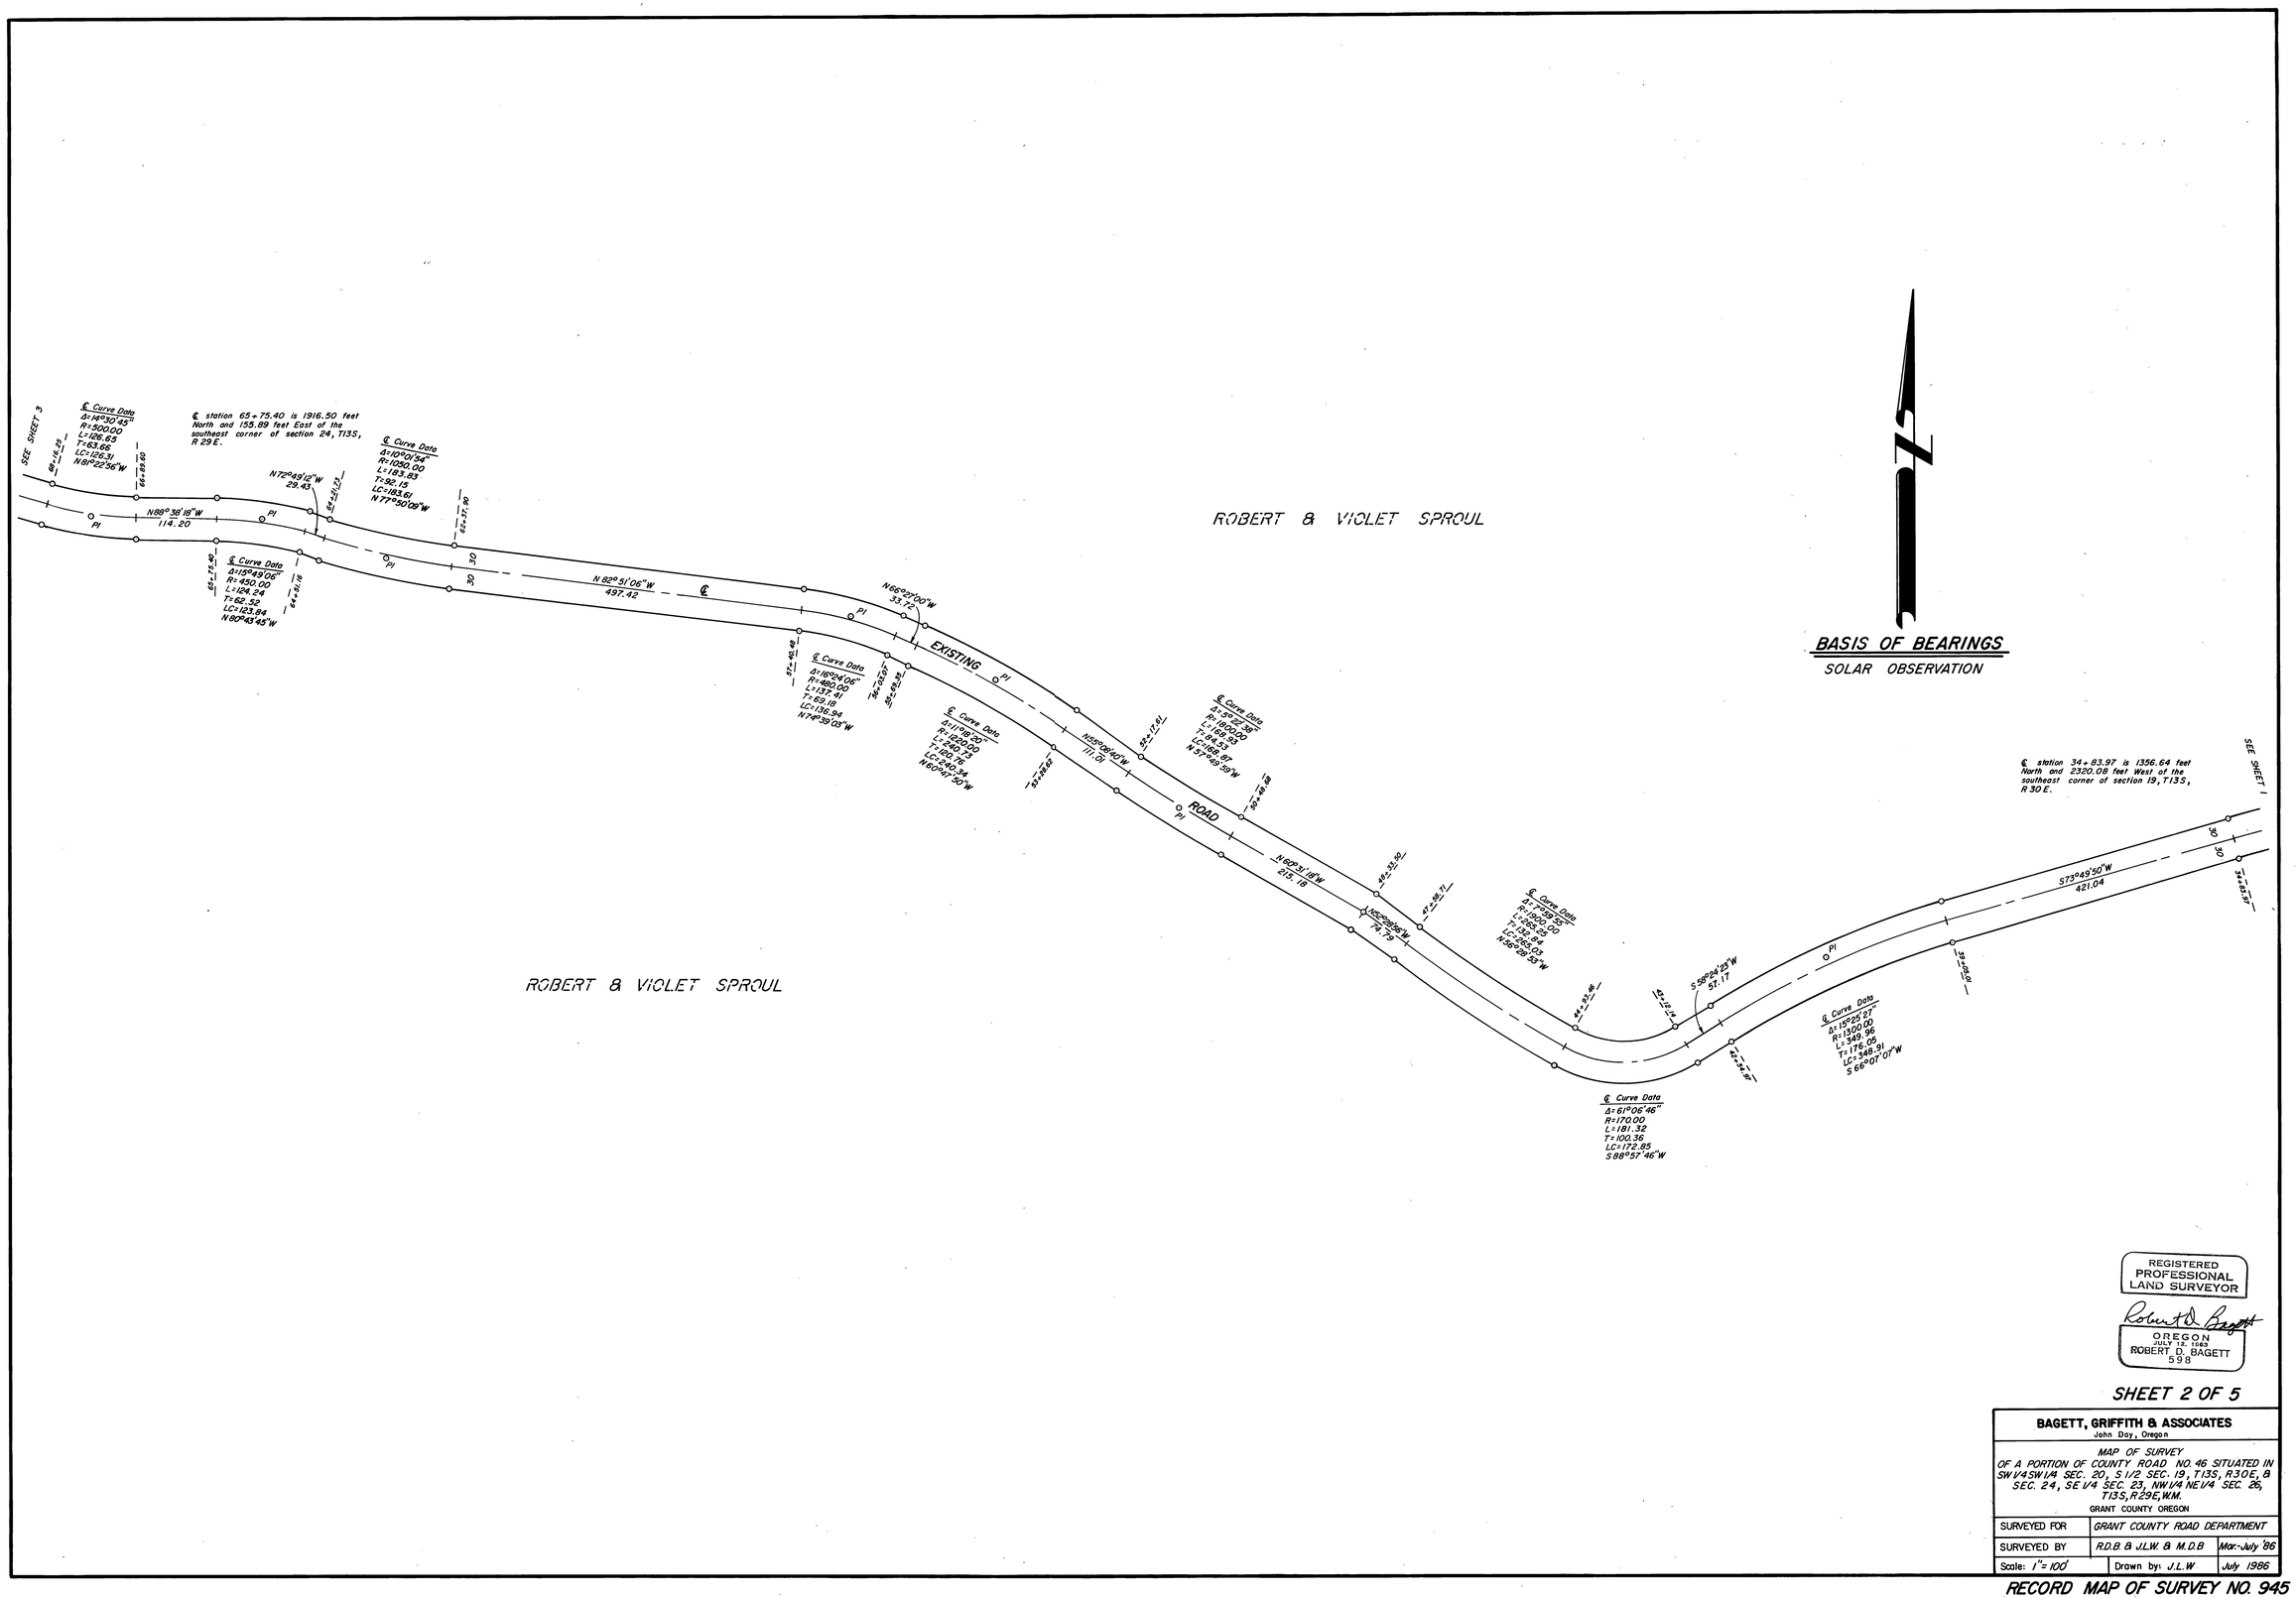

REGISTERED PROFESSIONAL LAND SURVEYOR

OREGON JULY 12, 1985 ROBERT D. BAGETT 598

SHEET 2 OF 5

BAGETT, GRIFFITH & ASSOCIATES
John Day, Oregon

MAP OF SURVEY
OF A PORTION OF COUNTY ROAD NO. 46 SITUATED IN SW1/4SW1/4 SEC. 20, S1/2 SEC. 19, T13S, R30E, & SEC. 24, SE1/4 SEC. 23, NW1/4 NE1/4 SEC. 26, T13S, R29E, W.M.
GRANT COUNTY OREGON

SURVEYED FOR	GRANT COUNTY ROAD DEPARTMENT	
SURVEYED BY	R.D.B. & J.L.W. & M.D.B	Mar.-July '86
Scale: 1"= 100'	Drawn by: J.L.W	July 1986

RECORD MAP OF SURVEY NO. 945