


End 2 1/2" alum. pipe with 3 1/4" alum. cap
visiting 15" in stone mound & 4 B.Ts.
11" R.P. line N 53° E 59.1'
14" R.P. line S 56° E 24.3'
17" R.P. line S 60° W 57.3'
9" Twp. N 84° W 82.5'

Cap marked
T135 R35E
S19 1520
S30 1529
1981
LS1026

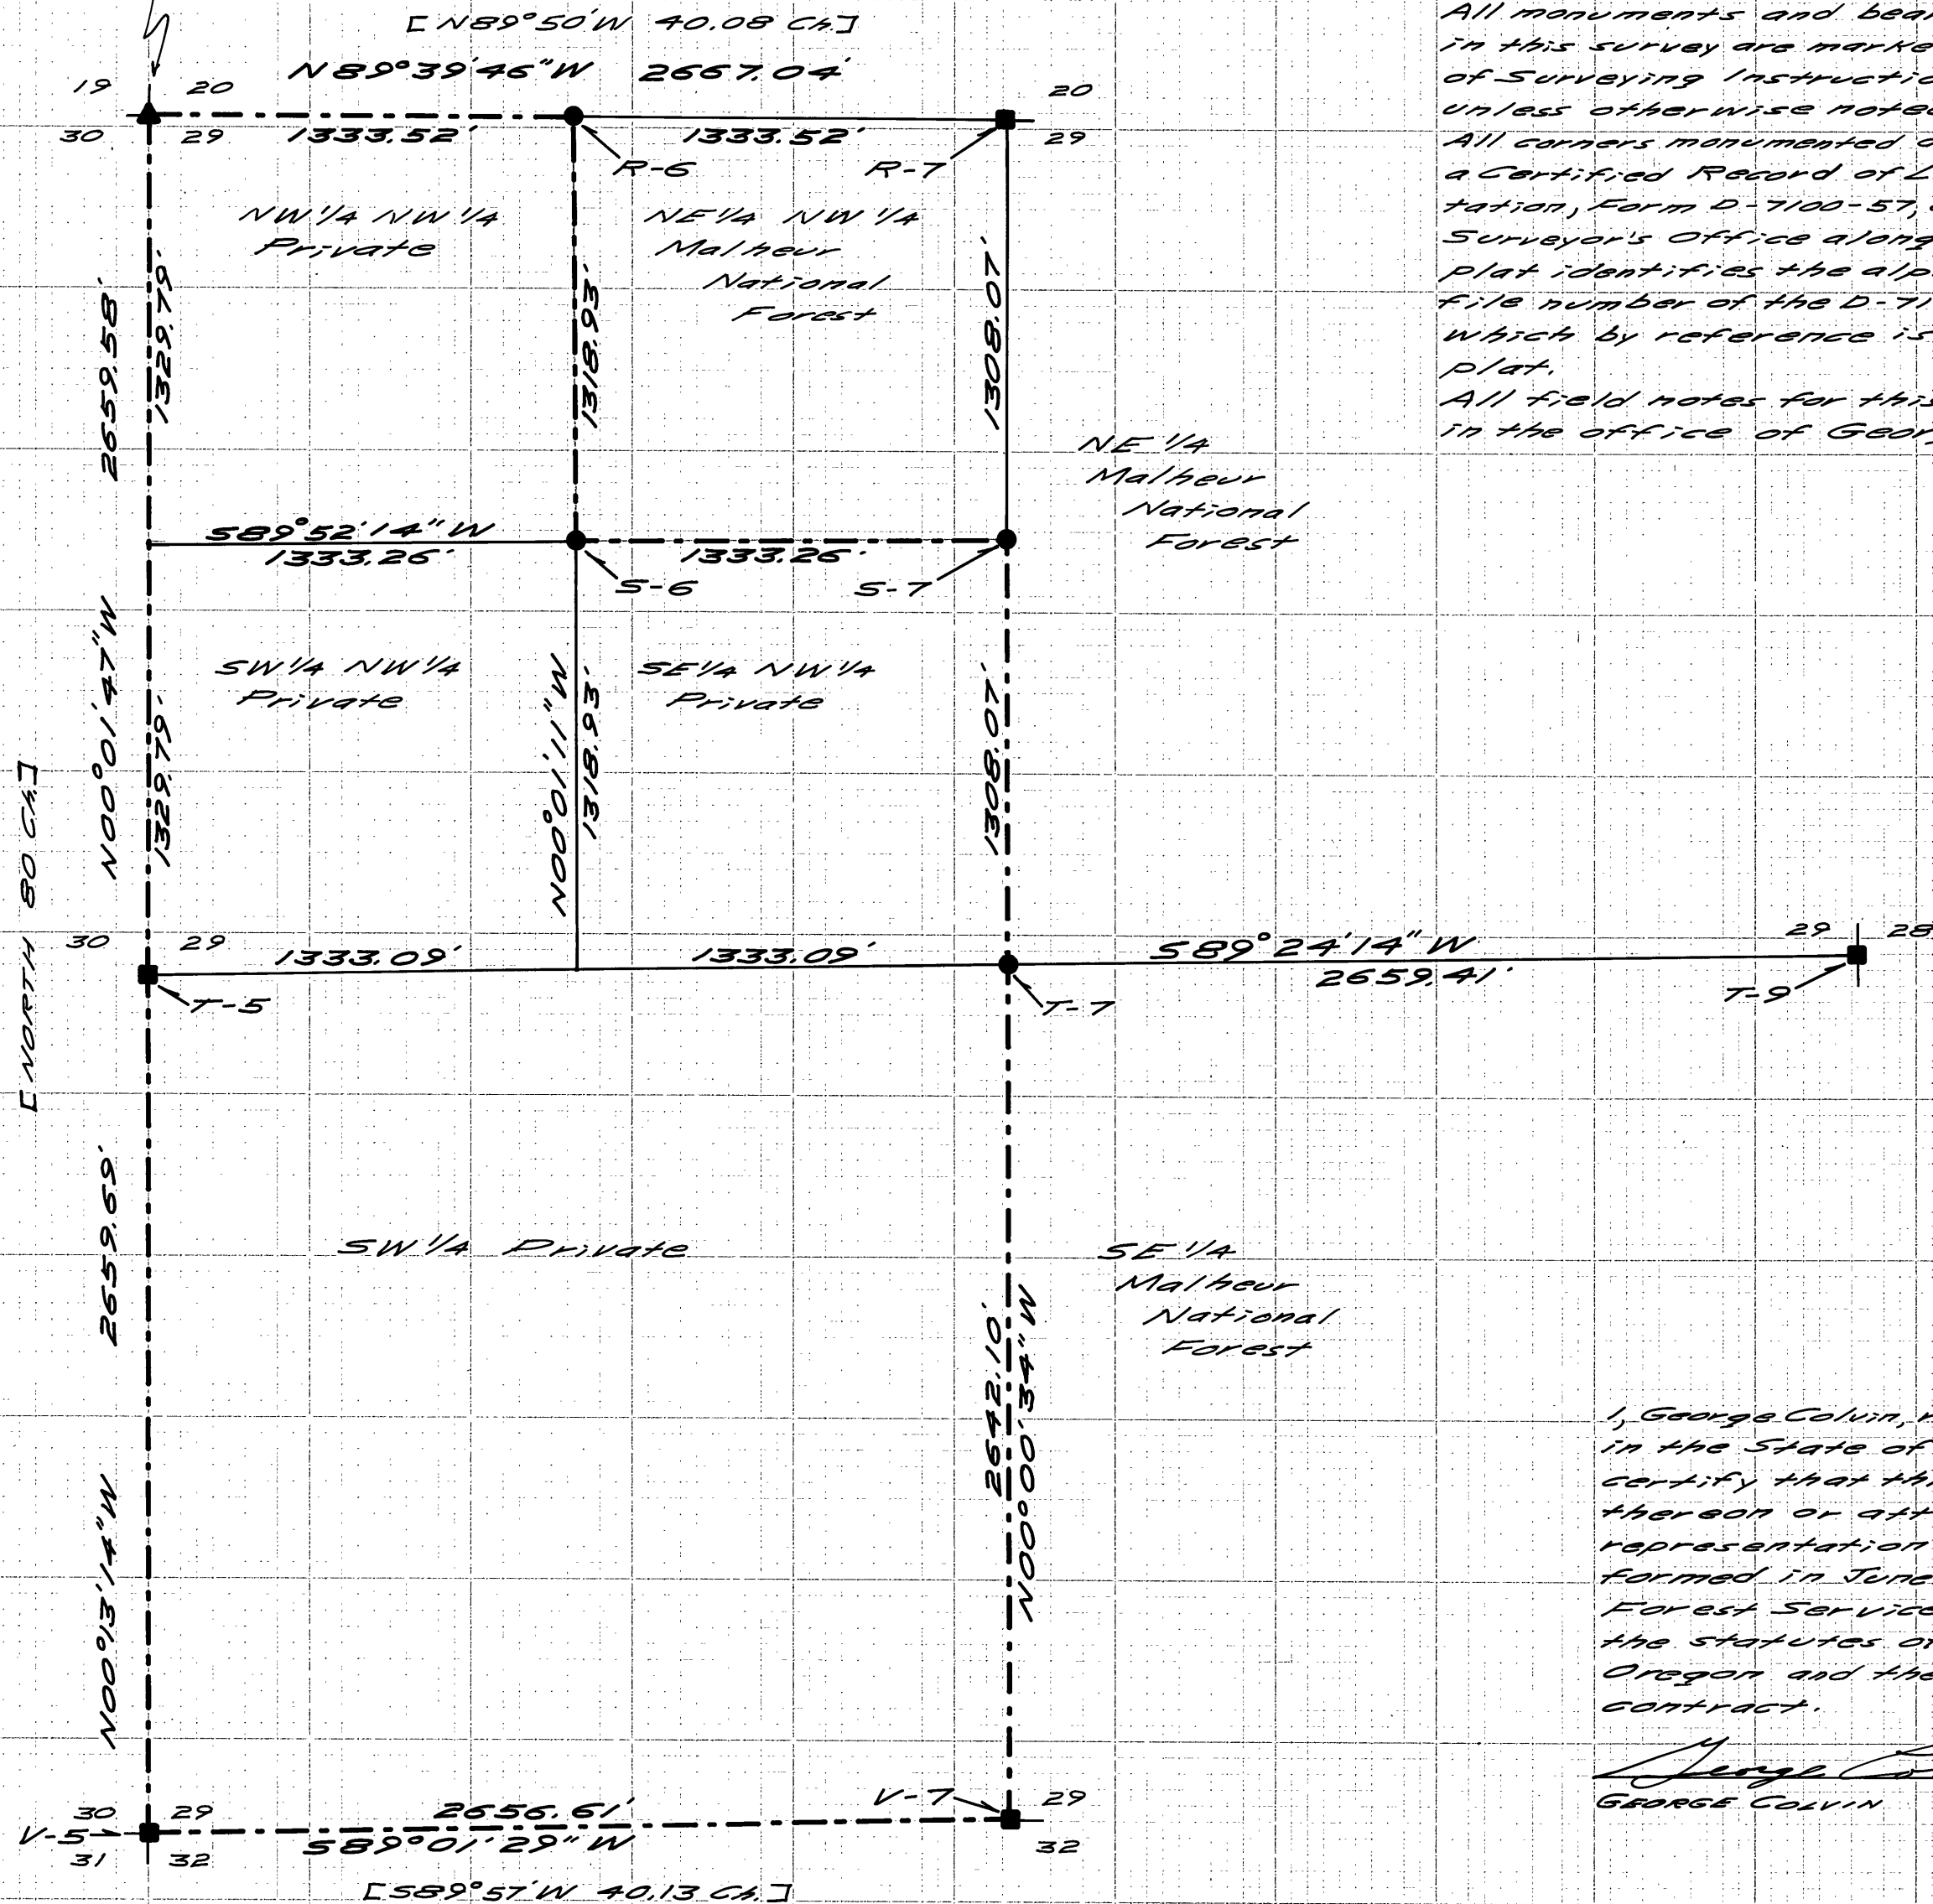

See Sheet 1 of 2

GENERAL NOTES

All monuments and bearing trees established in this survey are marked as per B.L.M. Manual of Surveying Instructions, 1973 Edition, unless otherwise noted on Forms D-7100-57. All corners monumented during this survey have a Certified Record of Land Corner Monumentation, Form D-7100-57, on file in the County Surveyor's Office along with this plat. The plat identifies the alpha-numeric index file number of the D-7100-57 for each corner, which by reference is made a part of this plat. All field notes for this survey are on file in the office of George Colvin.

500 0 150
FEET METERS
Scale: 1" = 500'
1 meter = 3.280833'

RECORD OF SURVEY
FOR MALHEUR NATIONAL FOREST
Located in Sections 29 & 32,
T135, R35E, W.M. and Sections
4 & 5, T14S, R35E, W.M.
Contract No. 53-04-H1-5-0180 N
Orange Cadastral Survey
Grant County, Oregon
July 5, 1986

I, George Colvin, registered land surveyor in the State of Oregon, do hereby certify that this plat and the notes thereon or attached are a correct representation of a survey I performed in June of 1986 for the U.S. Forest Service in accordance with the statutes of the State of Oregon and the articles of my contract.

George Colvin
GEORGE COLVIN ORALS-1020

REGISTERED
PROFESSIONAL
LAND SURVEYOR

George Colvin
OREGON
FEBRUARY 14, 1975
GEORGE W. COLVIN, JR.
1020

7/5/86

RECEIVED AND
FILED

SEP 8 1986

CLERK OF COUNTY SURVEYOR
Grant County, Oregon
Attest: *[Signature]*

SHEET 2 OF 2

GEORGE COLVIN
LAND SURVEYOR
20502 COVENTRY CIRCLE
BEND, OREGON 97702
PHONE: 382-2039