


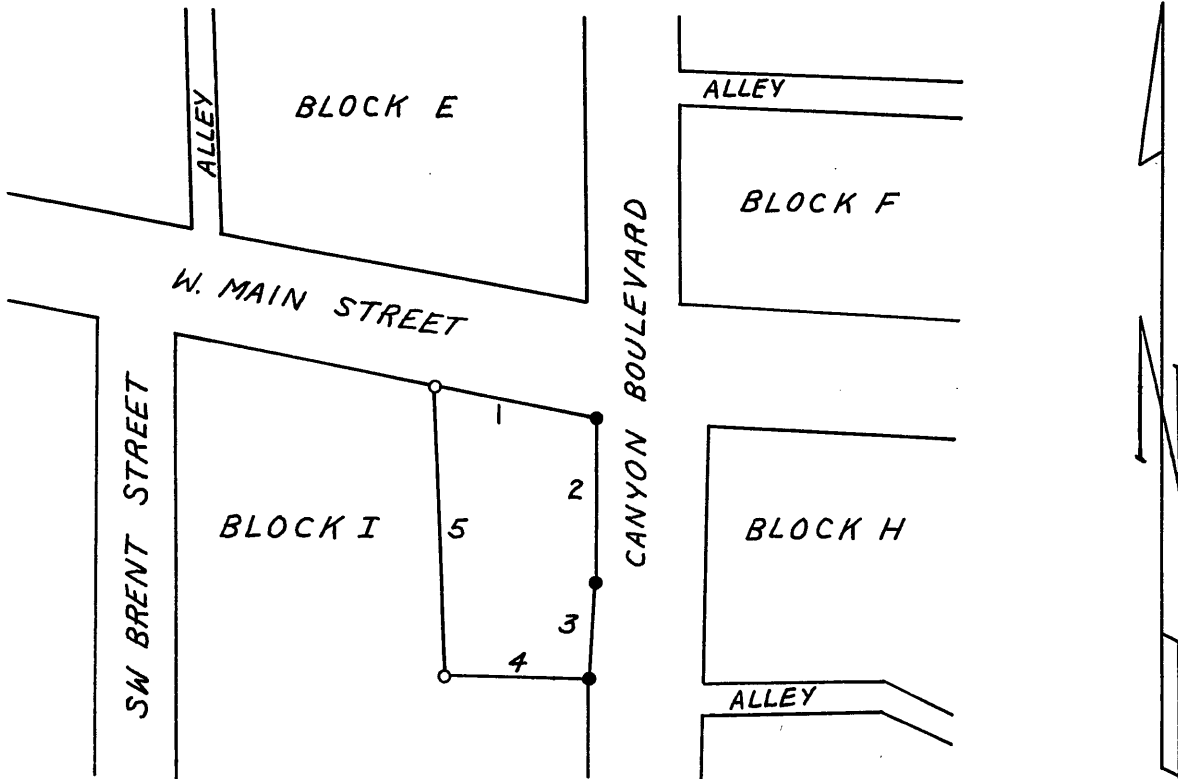

- 1 N 78° 08' W 78.00
- 2 N 0° 22' E 83.00
- 3 N 1° 54' E 50.00
- 4 S 88° 06' E 76.95
- 5 S 1° 05' W 146.49

- DENOTES 1/2" IRON PIN SET
- DENOTES BRASS SCREW SET

W. O. HARRIS & ASSOCIATES
 1022 20th Ave.
 Astoria, Oregon 97103
 503-325-1111

REGISTERED
 OREGON
 LAND SURVEYOR

Leland H. Ascher

JULY 10, 1964
 LELAND H. ASCHER
 635

WAYNE O. HARRIS & ASSOCIATES

SURVEY FOR

STANDARD OIL COMPANY

DESCRIPTIVE PARCEL
 BLOCK I
 JOHN DAY, OREGON

SCALE	DATE	DRN. BY	DRNG. No.
1"=100'	7-22-66	EKO	66-252