

CECIL SWAGGART

SW 1/4 NW 1/4

SEC 4

SEC. 3

SE 1/4 NE 1/4


WILLIAM REHDER

NW 1/4 SW 1/4

WILLIAM REHDER

NE 1/4 SE 1/4

NW 1/4 SE 1/4

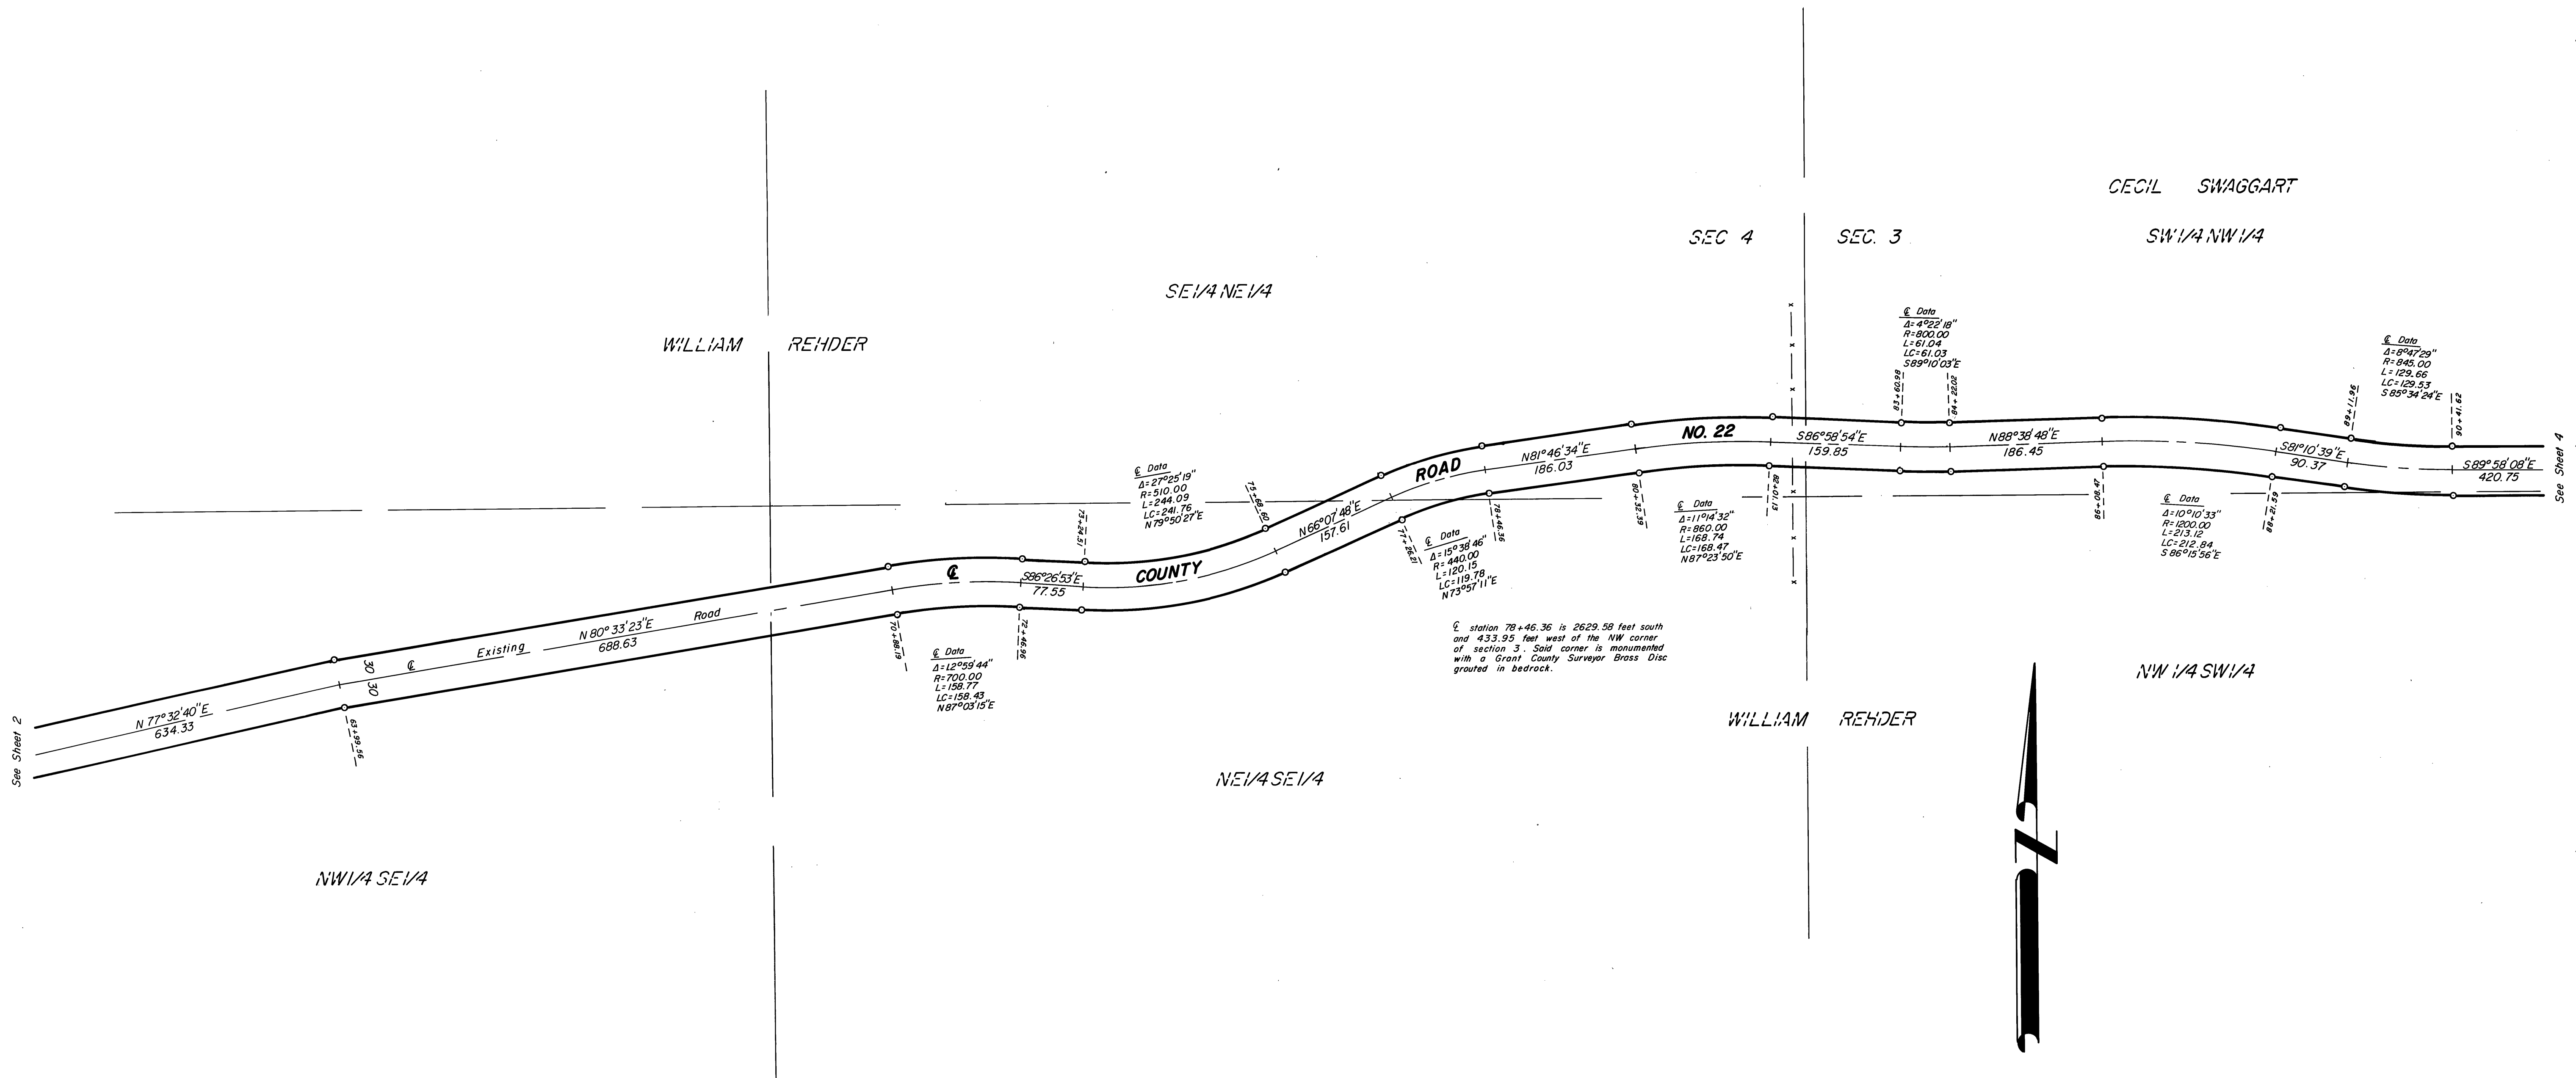

SHEET 3 OF 5

BAGETT, GRIFFITH & ASSOCIATES
John Day, Oregon

MAP OF SURVEY
OF COUNTY ROAD NO. 22 SITUATED WITHIN THE
N 1/2 S 1/2 B N 1/2 SEC. 3,
S 1/2 SEC. 4, S 1/2 SEC. 5, T 8 S, R 30 E, W. M.

GRANT COUNTY, OREGON

SURVEYED FOR GRANT COUNTY ROAD DEPARTMENT

SURVEYED BY R.D.B. & J.L.W. & M.D.B. Oct-Dec '86

Scale: 1"=100' Drawn by: J.L.W. Nov '86

REGISTERED
PROFESSIONAL
LAND SURVEYOR
Robert D. Bagett
OREGON
JULY 15, 1988
ROBERT D. BAGETT
598

RECEIVED AND
FILED

DEC 19 1986

OFFICE OF COUNTY SURVEYOR
John D. Baggett

RECORD MAP OF SURVEY NO. 964