


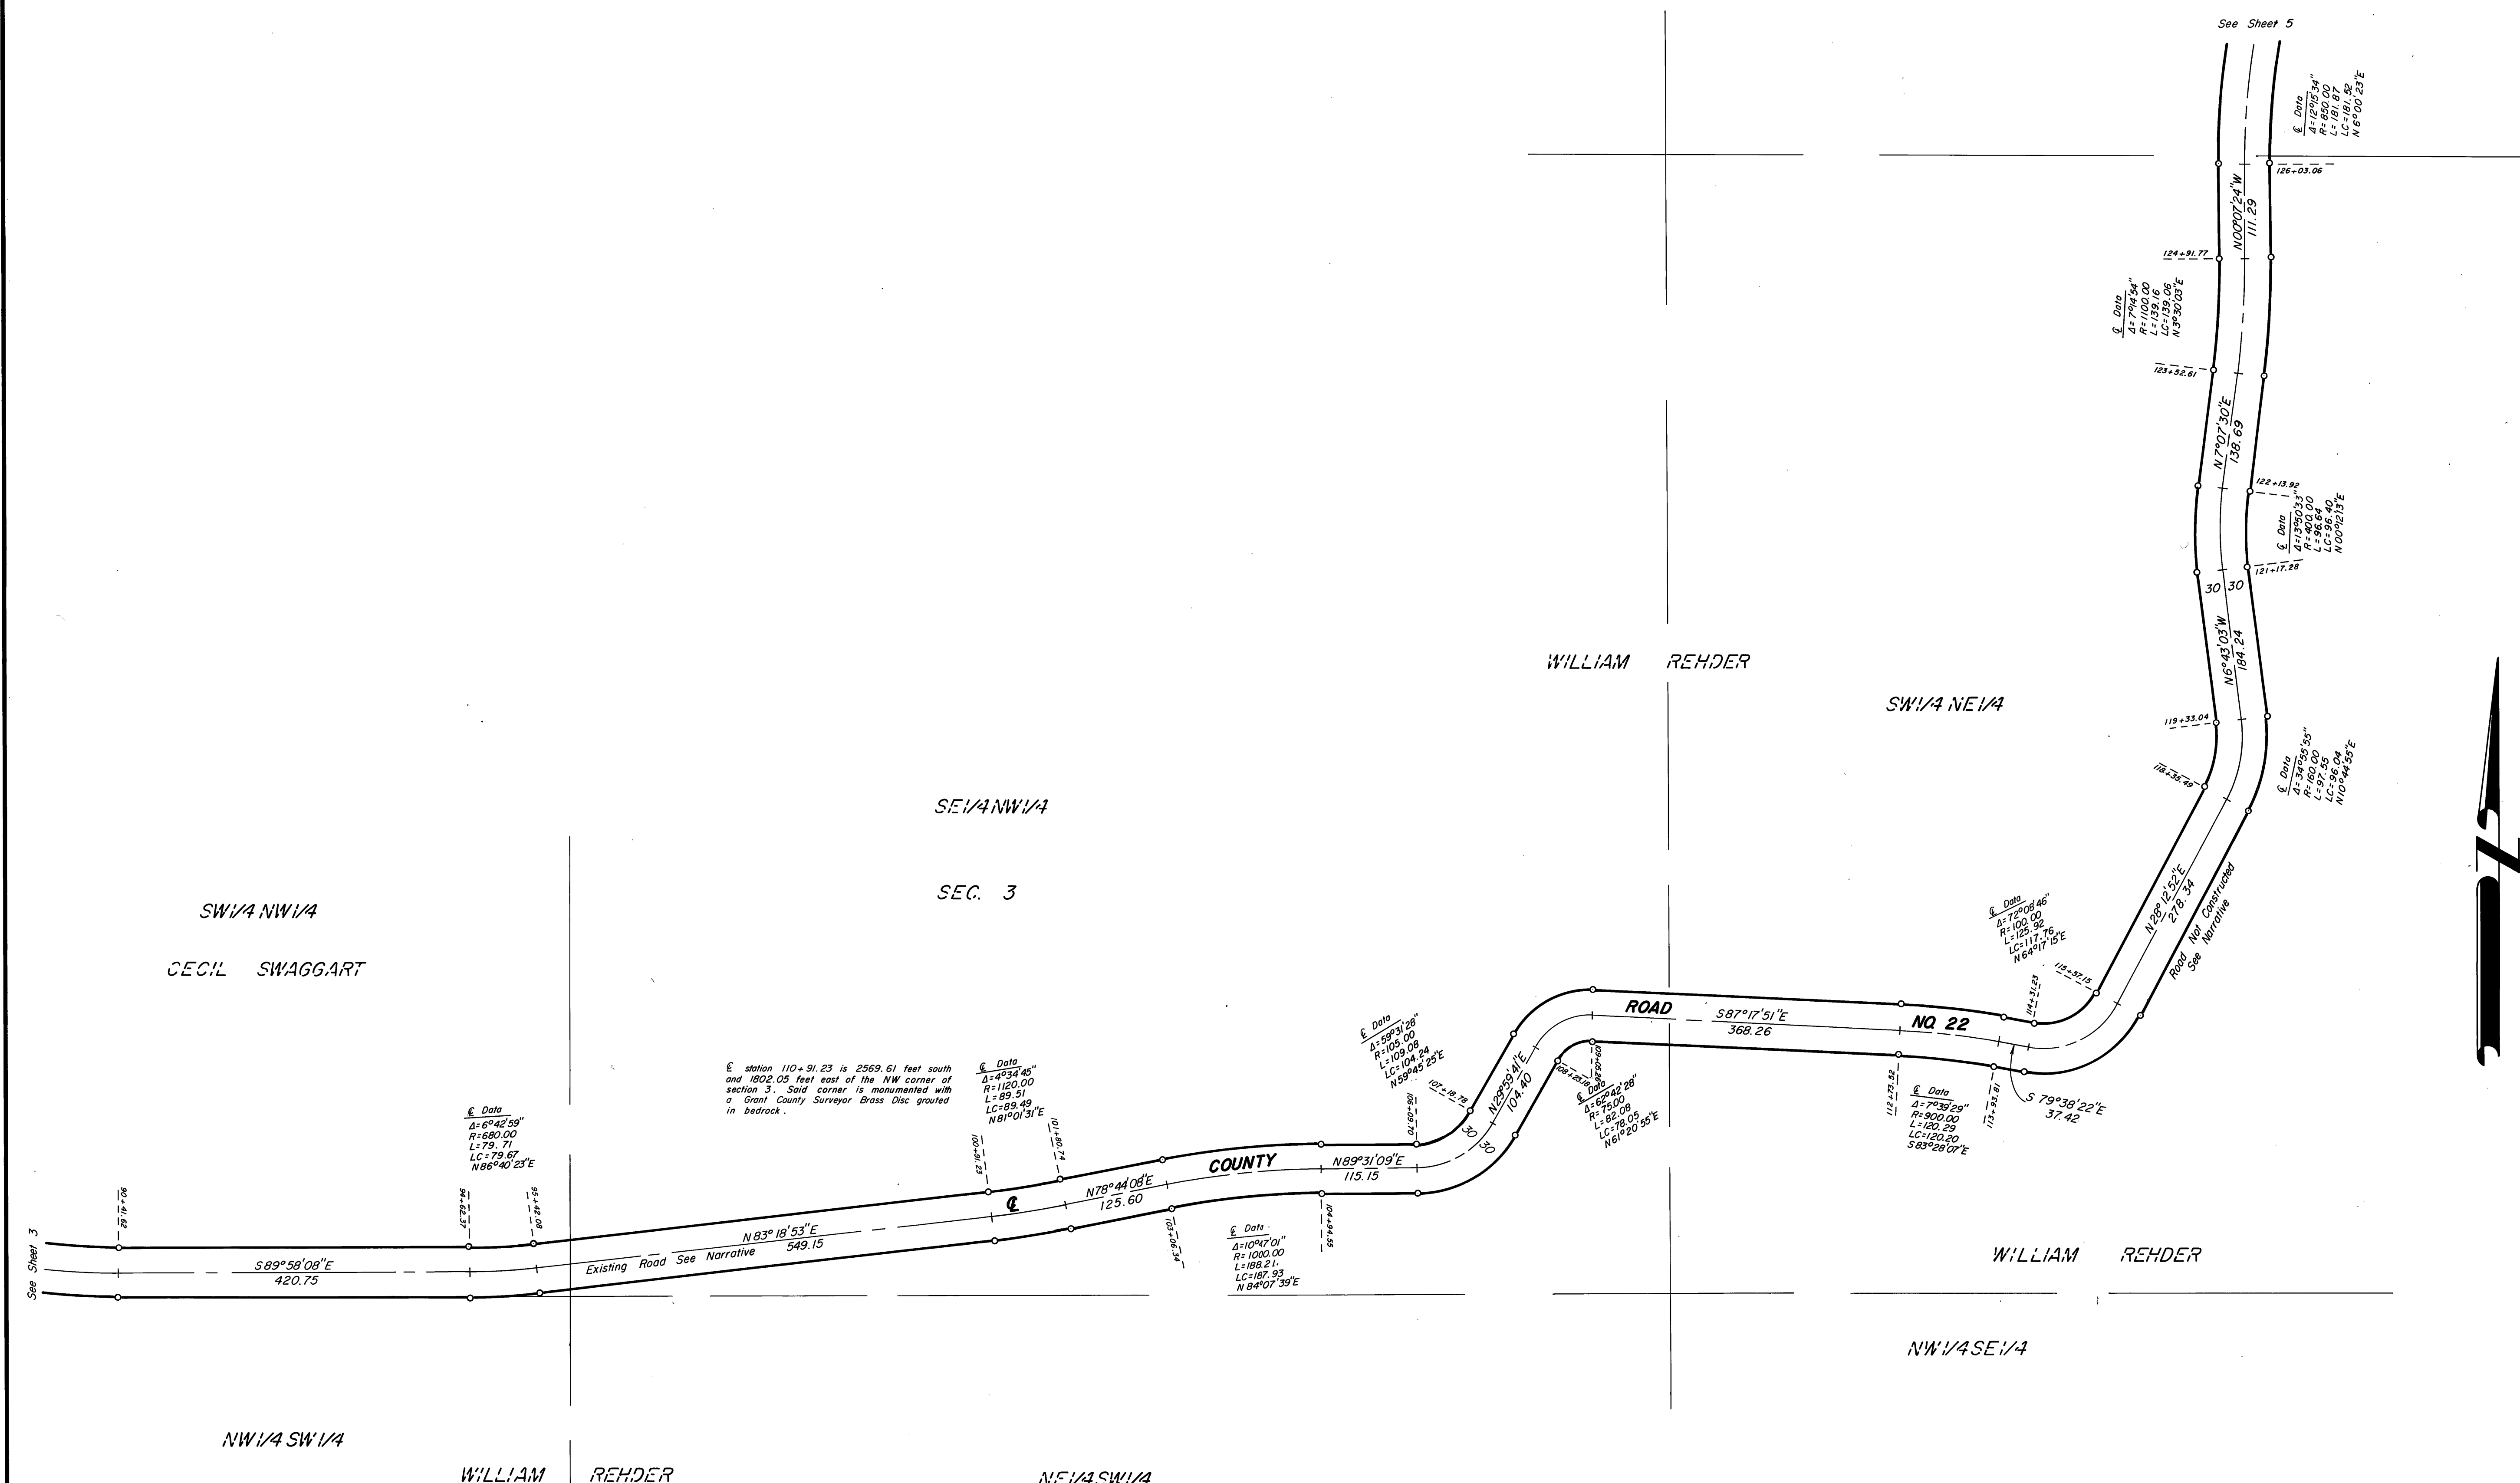

SHEET 4 OF 5

RECEIVED AND
FILED

DEC 19 1986

CLERK OF COUNTY SURVEYOR

JOHN W. B. BAGETT

REGISTERED
PROFESSIONAL
LAND SURVEYOR
Robert D. Bagett
ROBERT D. BAGETT
598

BAGETT, GRIFFITH & ASSOCIATES John Day, Oregon		
MAP OF SURVEY OF COUNTY ROAD NO. 22 SITUATED WITHIN THE N1/2 S1/2 & N1/2 SEC. 3, S1/2 SEC. 4, S1/2 SEC. 5, T8S, R30E, W.M.		
GRANT COUNTY, OREGON		
SURVEYED FOR	GRANT COUNTY ROAD DEPARTMENT	
SURVEYED BY	R.D.B. & J.L.W. & M.D.B.	Oct-Dec '86
Scale: 1"=100'	Drawn by: J.L.W.	Nov. '86

RECORD MAP OF SURVEY NO. 964