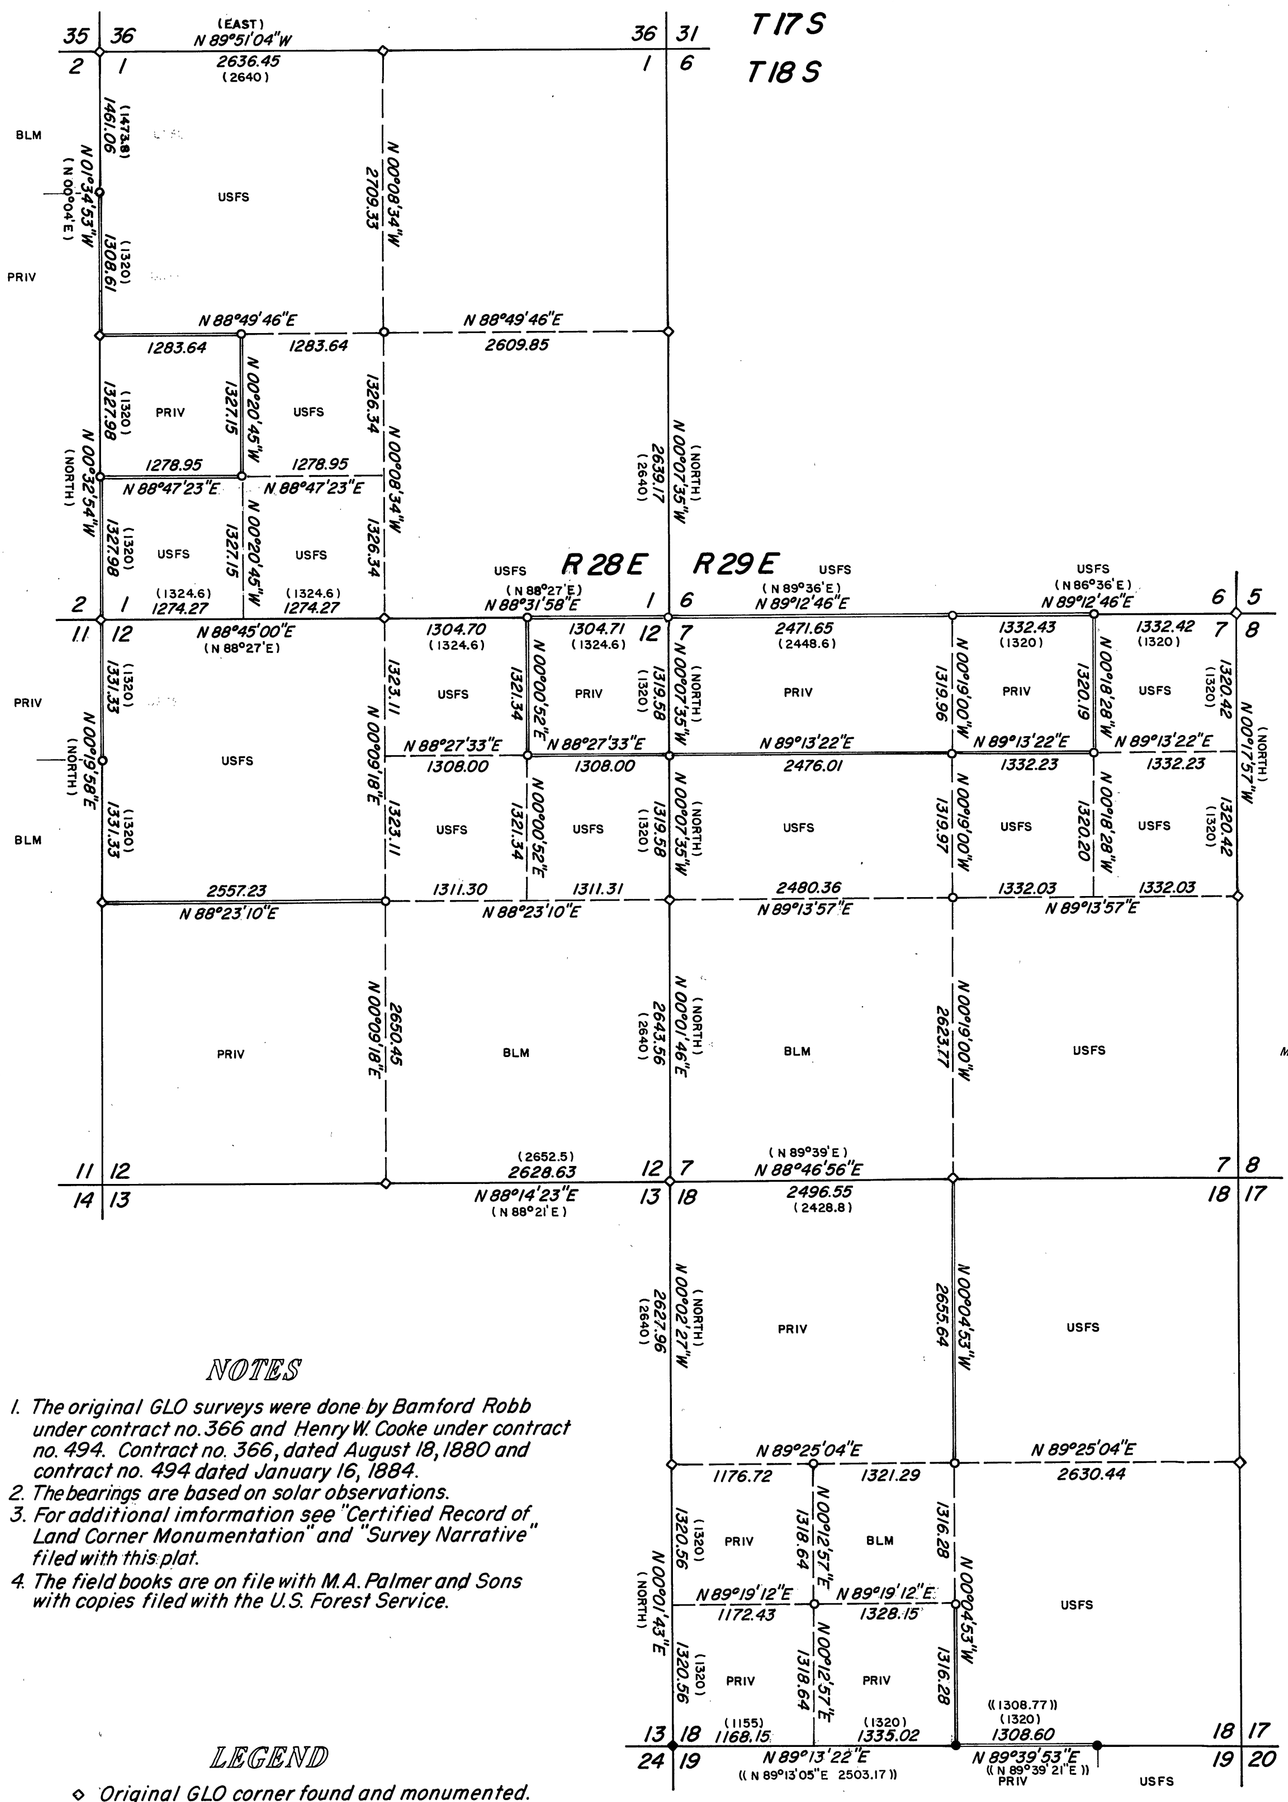

FEET 0 500 1000 1500 2000
METERS 0 100 200 300 400 500 600

SCALE

1 FOOT = 0.3048 METERS
1 METER = 3.280 FEET

NOTES

1. The original GLO surveys were done by Bamford Robb under contract no. 366 and Henry W. Cooke under contract no. 494. Contract no. 366, dated August 18, 1880 and contract no. 494 dated January 16, 1884.
2. The bearings are based on solar observations.
3. For additional imformation see "Certified Record of Land Corner Monumentation" and "Survey Narrative" filed with this plat.
4. The field books are on file with M.A. Palmer and Sons with copies filed with the U.S. Forest Service.

LEGEND

- ◇ Original GLO corner found and monumented.
- ◆ Brass capped monument found, Grant Co. Survey no. 611.
- ● Alum. capped monument found, Grant Co. Survey no. 877.
- ○ Alum. capped monument set.
- —— Section lines
- — — Section subdivisional lines
- ═══ Forest Boundary, posted
- USFS Forest Service administrated lands
- BLM B.L.M. administrated lands.
- PRIV Private lands
- ( ) Distance and bearing of record, GLO surveys.
- (( )) Distance and bearing of record, Grant County Survey no. 877.

CERTIFICATION

I, Chris T. Palmer, registered in accordance with the laws of the State of Oregon, hereby certify that this plat and notes hereon are a true representation of a survey we performed in 1986 for the U. S. Forest Service in accordance with the statutes of the State of Oregon and the terms of our contract (no. 53-04H1-5-0137N).

Chris T. Palmer, PLS
Oregon licence no. 1288

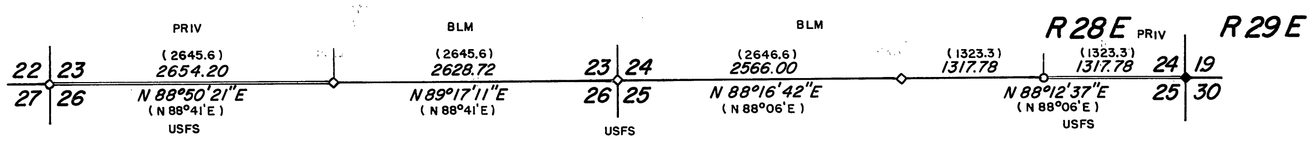

RECEIVED AND FILED
APR 6 1987
OFFICE OF COUNTY SURVEYOR
RECORDER

REGISTERED PROFESSIONAL LAND SURVEYOR
OREGON SEPTEMBER 23, 1977 CHRIS T. PALMER 1288

U.S. FOREST SERVICE

SURVEY PLAT

MALHEUR NAT'L FOREST

GRANT COUNTY PORTION OF THE "BOWL CADASTRAL"
T18 S, R 28 E, R 29 E, WM, GRANT COUNTY, OREGON.

Scale: 1" = 1000'	Date: NOV. 1986	Job: 933
Dsn:		
Drn: CTP		
Ckd: CTP		

M&P's — M. A. Palmer & Sons, ENGINEERING & SURVEYING, 254 N. Alder - Box 61, Burns, Oregon 97720

Sht. No. 1 of 1

GRANT COUNTY SURVEY NO. 968

M.&S. 968