


MAP of SURVEY
IN SECTIONS 3 & 10
T 13 S, R 27 E, W. M.
GRANT COUNTY, OREGON

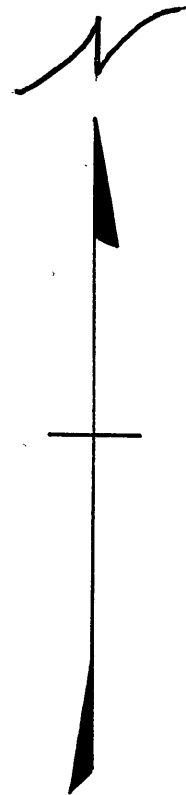


BASIS OF BEARINGS
Solar observation near the cor.
of sections 2, 3, 10, & 11

4 | 3
9 | 10

Fd. scribed 11" X 8" X 13" stone,
in a mound of stone.
Replace stone with brass cap.
Set 5' steel fence post, 3' So.

(Rec. N 89° 30' W 5318.2)
S 89° 34' 00" W 5394.71

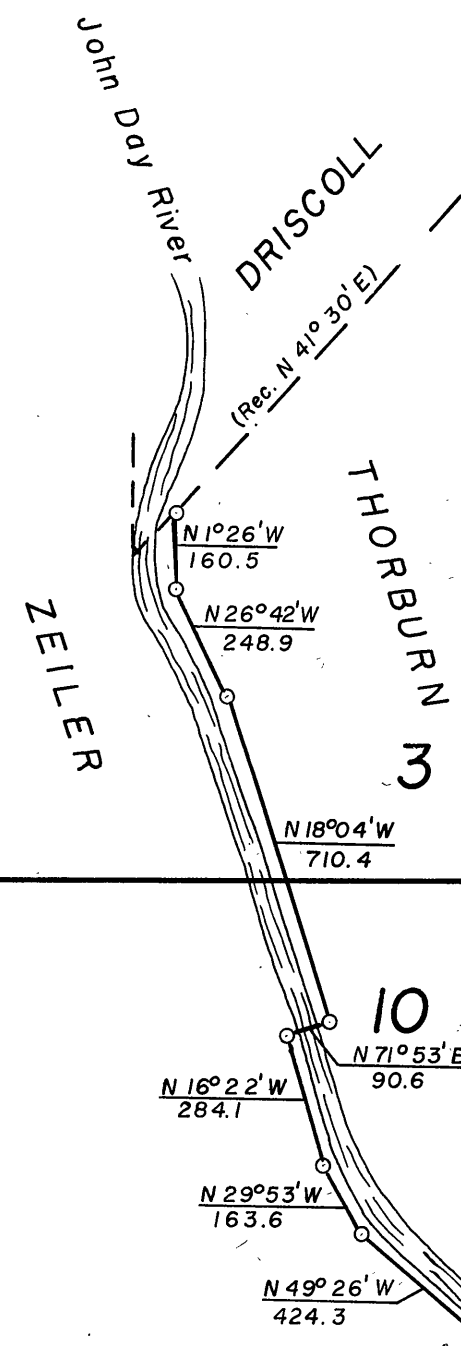

34 | 35
3 | 2
N 0° 10' 11" W 2511.44

Fd. brass cap & marked stone.
New B.T. marked as follows:
A juniper 8" dia. bears S 86 E; 96.3'
A juniper 12" dia. bears S 18 E; 126.1'

RECEIVED AND
FILED
JUL 10 1968
JOHN LIVEIRA, County Clerk
By _____ Deputy

Set brass cap at proportionate measure, 18 in.
below the surface, from which:
a 1/2" iron pin bears S 1° 19' 40" W; 183.50'
a spike, in center line of highway bears
S 1° 19' 40" W; 272.55'
a 1/2" iron pin bears S 89° 34' 00" W; 90.45'
a spike, in center line of highway bears
S 89° 34' 00" W; 134.61'

(Rec. S 89° 54' W 2671.7)
S 86° 40' 17" E 2714.64

Fd. 16" x 8" x 7" stone in
a mound of stone, m'k 1/4
Replaced stone with
brass cap. Set 5' steel
fence post 2' West.

10 | 11
S 1° 19' 40" W 2722.48
(Rec. South 2640.0)
1361.24
2651.33

Fd. 17" x 7" x 10" stone in a
mound of stone, m'k 1/4.
Replaced stone with brass cap.
New B.T. marked as follows:
A juniper 8" dia. bears N 76 W; 28.4'
Set 5' steel fence post 1' South.

10 | 11
15 | 14
S 0° 12' 38" W 2651.33
Fd. brass cap.

LEGEND

- ⊙ BRASS CAP SET
- MONUMENT FOUND
- 5/8" iron pin set

Brass caps marked with date and
Grant County Surveyor and the
proper nomenclature as prescribed
in the BLM manual.

REGISTERED
OREGON
LAND SURVEYOR
DUANE L. GRIFFITH
JULY 10, 1964
644

BAGETT & GRIFFITH SURVEYING			
JOHN DAY, OREGON			
Surveyed for	THOMAS F. THORBURN ROY W. ZEILER		
Surveyed by	D.I.G. & R.D.B.		Jan. 1968
Drawn by	D.I.G.		Jan 1968
SCALE: 1 in. = 400 ft.			

Survey # 98