


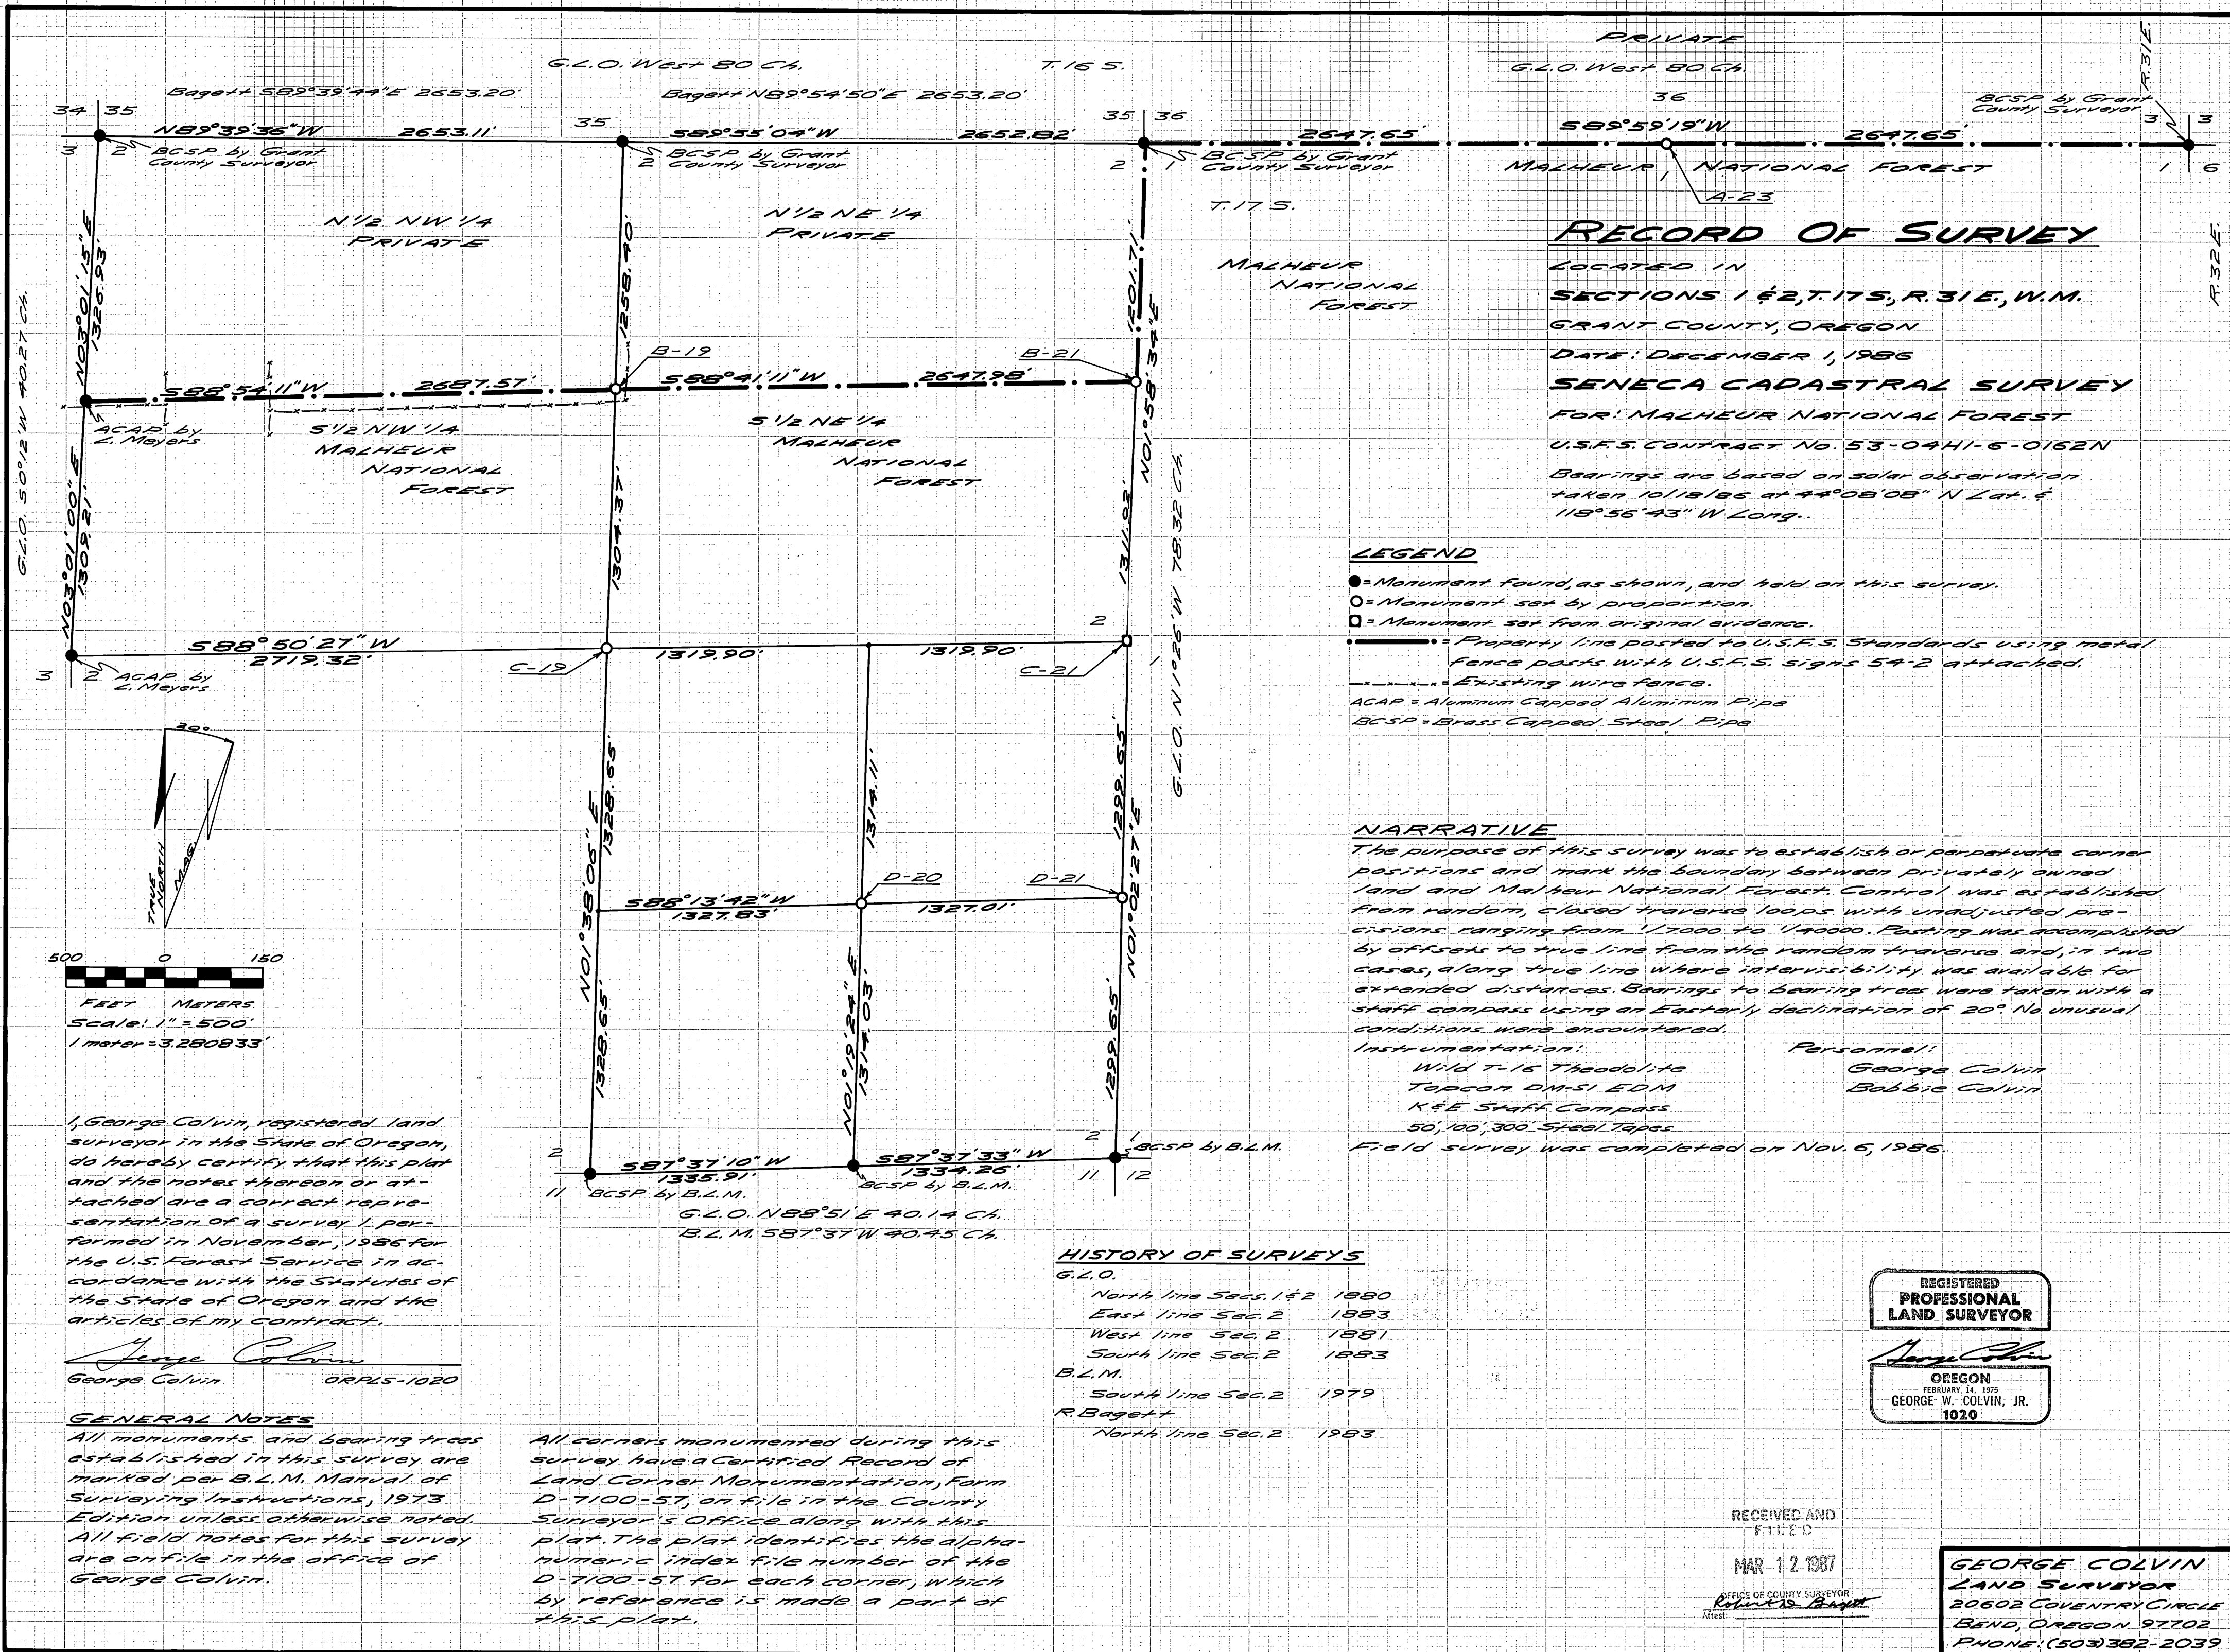

RECORD OF SURVEY

LOCATED IN
SECTIONS 1 & 2, T.17S, R.31E, W.M.
GRANT COUNTY, OREGON
DATE: DECEMBER 1, 1986
SENECA CADASTRAL SURVEY
FOR: MALHEUR NATIONAL FOREST
U.S.F.S. CONTRACT NO. 53-04HI-6-0162N
Bearings are based on solar observation
taken 10/18/86 at 44°08'08" N Lat. &
115°56'43" W Long.

LEGEND

- = Monument found, as shown, and held on this survey.
- = Monument set by proportion.
- = Monument set from original evidence.
- = Property line posted to U.S.F.S. Standards using metal fence posts with U.S.F.S. signs 54-2 attached.
- - - = Existing wire fence.
- ACAP = Aluminum Capped Aluminum Pipe
- BCSP = Brass Capped Steel Pipe

NARRATIVE

The purpose of this survey was to establish or perpetuate corner positions and mark the boundary between privately owned land and Malheur National Forest. Control was established from random, closed traverse loops with unadjusted precisions ranging from 1/7000 to 1/4000. Posting was accomplished by offsets to true line from the random traverse and, in two cases, along true line where intervisibility was available for extended distances. Bearings to bearing trees were taken with a staff compass using an Easterly declination of 20°. No unusual conditions were encountered.

Instrumentation:
Wild T-16 Theodolite
Topcon DM-51 EDM
K&E Staff Compass
50', 100', 300' Steel Tapes
Field survey was completed on Nov. 6, 1986.

Personnel:
George Colvin
Bobbie Colvin

HISTORY OF SURVEYS

- G.L.O.
North line Secs. 1 & 2 1880
East line Sec. 2 1883
West line Sec. 2 1881
South line Sec. 2 1883
- B.L.M.
South line Sec. 2 1979
- R. Baggett
North line Sec. 2 1983

I, George Colvin, registered land surveyor in the State of Oregon, do hereby certify that this plat and the notes thereon or attached are a correct representation of a survey I performed in November, 1986 for the U.S. Forest Service in accordance with the Statutes of the State of Oregon and the articles of my contract.

George Colvin
George Colvin ORPLS-1020

GENERAL NOTES

All monuments and bearing trees established in this survey are marked per B.L.M. Manual of Surveying Instructions, 1973 Edition unless otherwise noted. All field notes for this survey are on file in the office of George Colvin.

All corners monumented during this survey have a Certified Record of Land Corner Monumentation, Form D-7100-57, on file in the County Surveyor's Office along with this plat. The plat identifies the alpha-numeric index file number of the D-7100-57 for each corner, which by reference is made a part of this plat.

REGISTERED
PROFESSIONAL
LAND SURVEYOR

George Colvin
OREGON
FEBRUARY 14, 1975
GEORGE W. COLVIN, JR.
1020

RECEIVED AND
FILED
MAR 12 1987
OFFICE OF COUNTY SURVEYOR
Grant County, Oregon

GEORGE COLVIN
LAND SURVEYOR
20602 COVENTRY CIRCLE
BEND, OREGON 97702
PHONE: (503) 382-2039