


MAP OF SURVEY

SUBDIVISION OF SECTIONS 16 & 17, T17S, R31E, WM

LEGEND

- Section Corners Set by Survey
- Section & 1/4 Corners Previously Set
- Section & 1/4 Corners Set by Found Evidence
- C1/4 Corners Set by Survey
- 1/16 Corners Previously Set
- 1/16 Corners Set by Survey
- Posted National Forest Boundary Lines
- NF Boundary Not Posted This Survey
- Section Lines
- Center Section Lines
- Projected Lines
- Legal Subdivision of USFS Property
- Record Bearing & Distance in Parentheses
- Certified Corner Record Index No.
See Corner Restoration Records
- Monuments Set by This Survey are 2" Aluminum Pipes with 3/4" Aluminum Caps

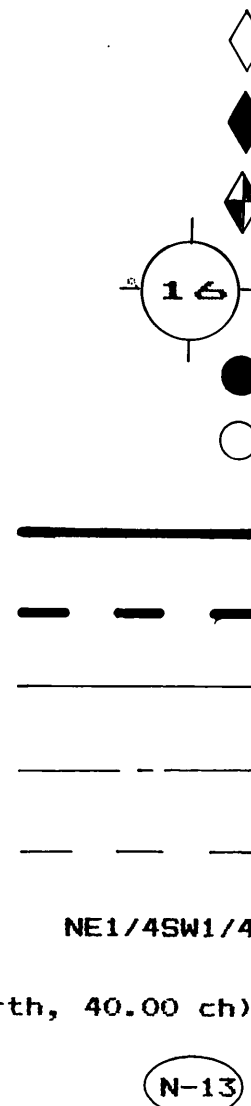


Basis for Bearings
Solar Observation
Assumed Magnetic Declination 18° 30'E



CERTIFICATION

I, Leland Lee Myers, a Professional Land Surveyor registered in the State of Oregon, office located at 587 E. Auburn St., P.O. Box 98, Sumpter, OR 97877, do hereby certify that I did perform this survey October 17 to November 19, 1986, as a contractor at the request of the USDA-Forest Service by Rail Cadastral Survey Contract No. 53-04H1-5-0125N and that the information shown hereon is correct to the best of my knowledge.

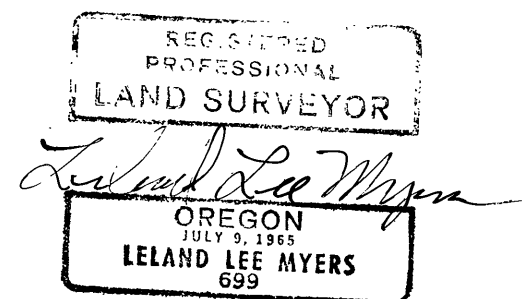

PROOF OF RECORDING


The following CERTIFIED RECORDS OF LAND CORNER MONUMENTATION in T17S, R31E, WM, were received from Leland Lee Myers, PLS 699 with these Maps of Survey 1 & 2 to be entered into the official county surveyor records.

Corner Index Nos.	No. of Corners Monumented
MAP 2: C-9, E-9, J-7, J-9, J-11, K-12, L-5, L-7, L-9, L-10, L-11, L-12, M-7, M-9, M-10, N-7, N-9 & N-11	18
Total Corners Submitted With These Maps for T17S, R31E	26

I hereby certify that the CERTIFIED RECORDS OF LAND CORNER MONUMENTATION listed above have been filed in the Office of the Grant County Surveyor this 6 day of April, 1987.

Robert D. Baggett
Grant County Surveyor

See NARRATIVE OF SURVEY on MAP 1

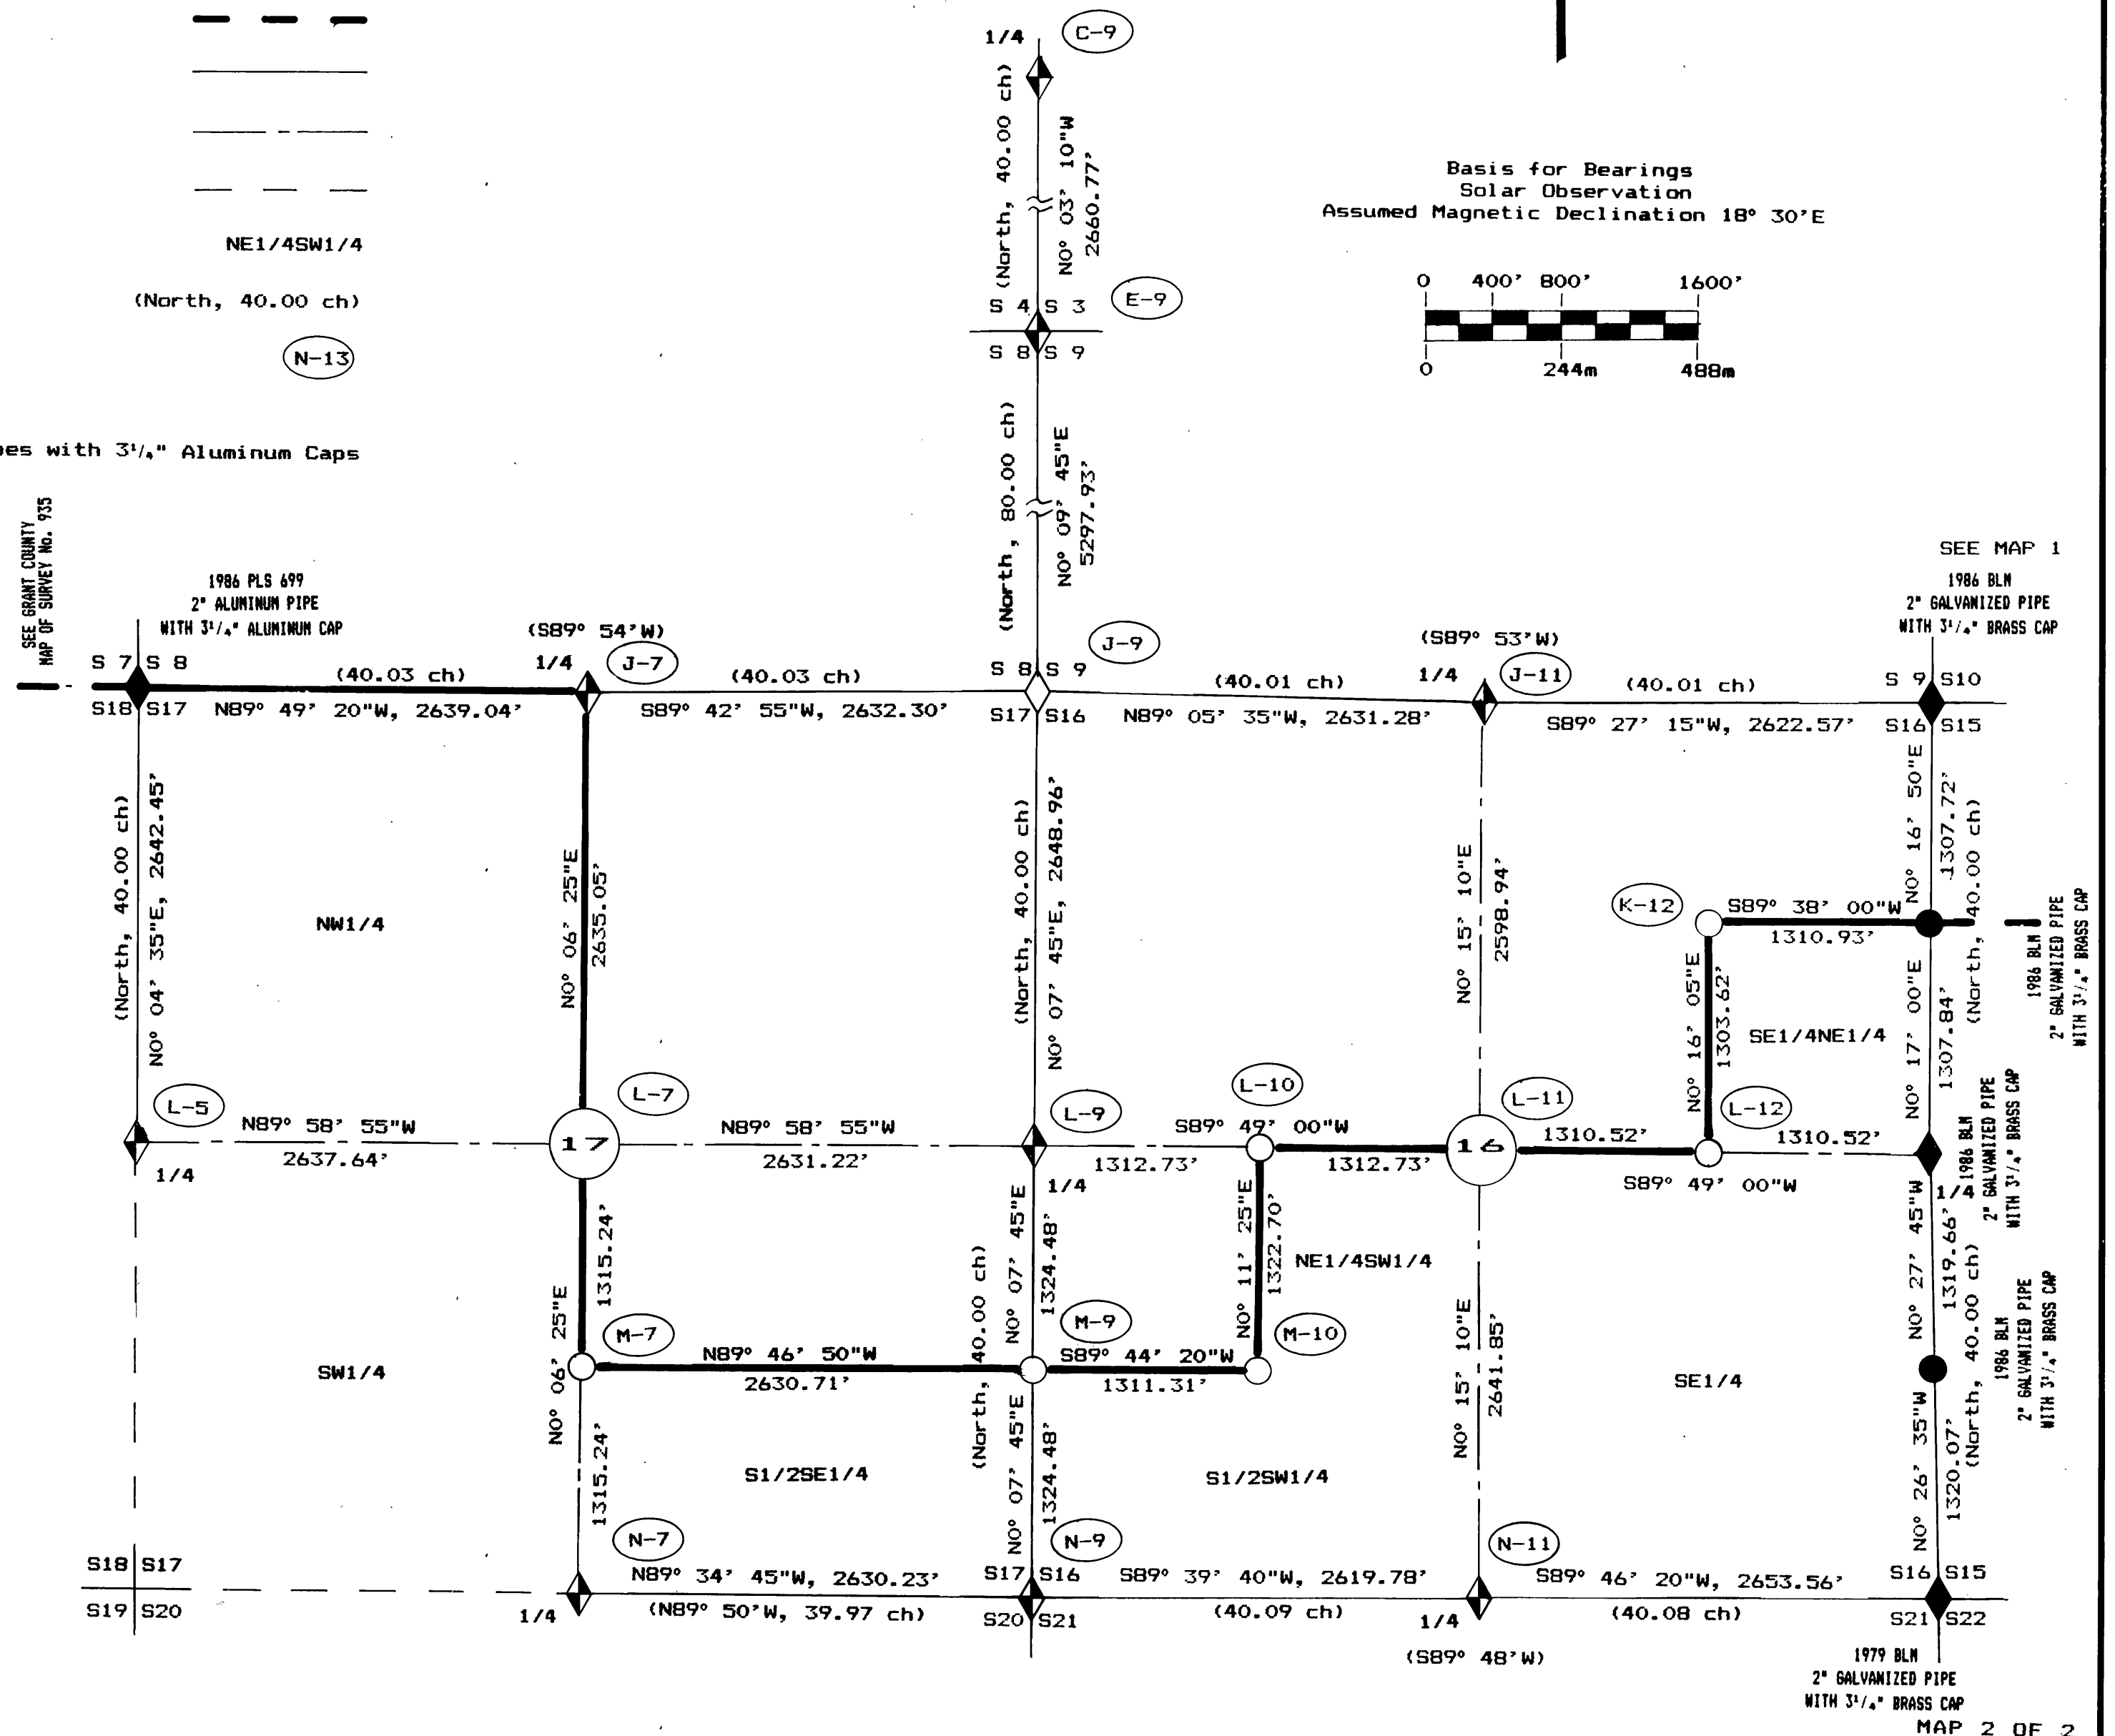

1979 BLM
2" GALVANIZED PIPE
WITH 3/4" BRASS CAP

MAP 2 OF 2