
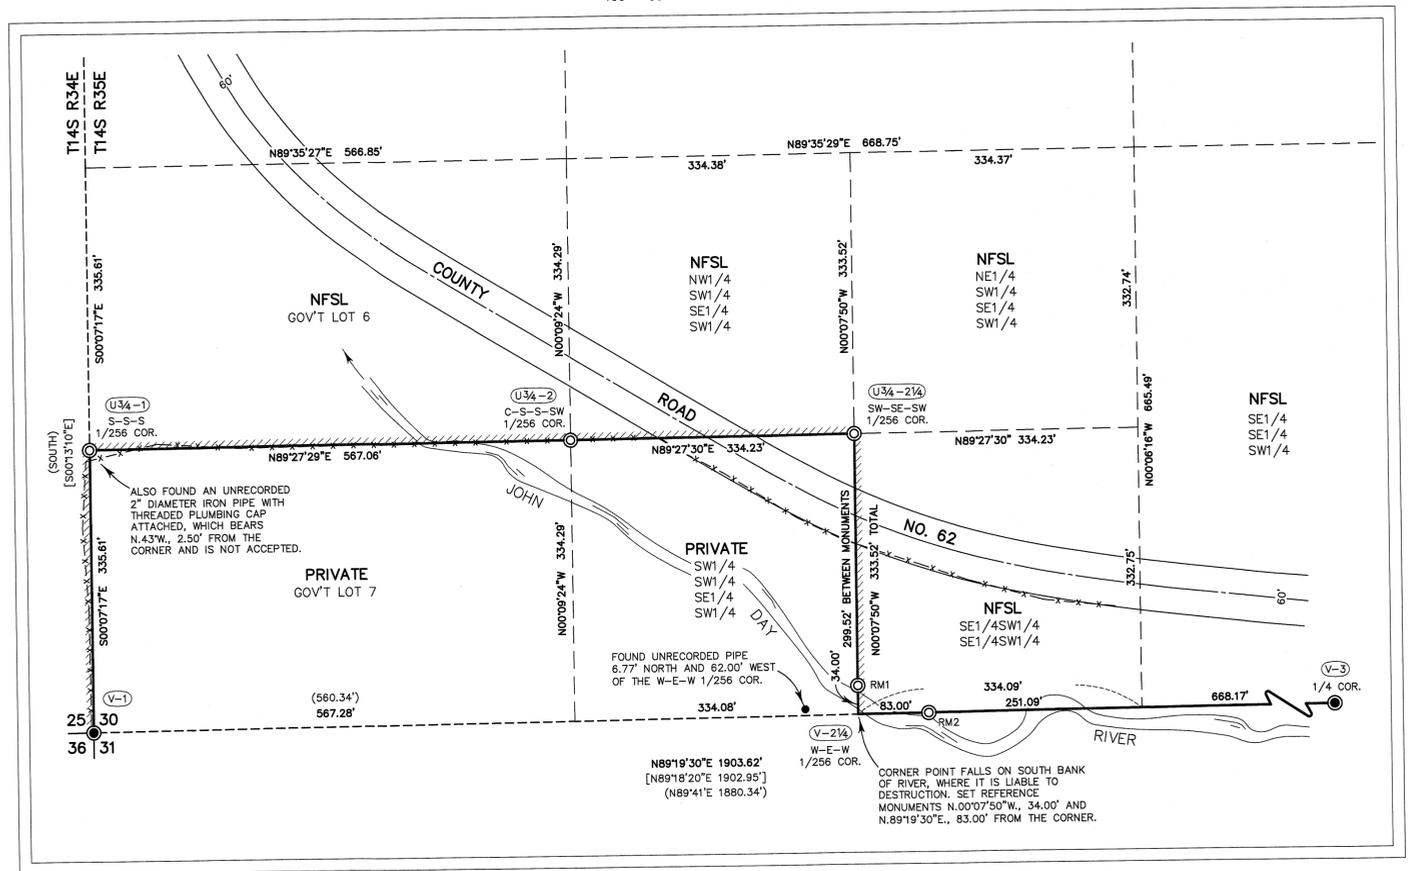


**DETAIL**

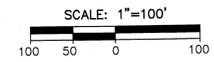

**NARRATIVE**

THIS SURVEY WAS PERFORMED FOR THE MALHEUR NATIONAL FOREST, WITH THE PURPOSE OF LOCATING THE BOUNDARIES OF THAT CERTAIN TRACT OF LAND ORIGINALLY DESCRIBED IN BOOK 93 PAGE 95, DEED RECORDS OF GRANT COUNTY, OREGON. THIS REQUIRED A DEPENDANT RESURVEY AND SUBDIVISION OF SECTION 30, T.14S., R.35E. A SEARCH WAS MADE OF THE AVAILABLE RECORDS PERTAINING TO THIS SURVEY. A HISTORY OF THE RELEVANT SURVEYS ARE AS FOLLOWS:

- A PORTION OF THE WEST BOUNDARY OF TOWNSHIP 14 SOUTH, RANGE 35 EAST WAS SURVEYED BY HOMER D. ANGELL, U.S. DEPUTY SURVEYOR, UNDER CONTRACT NO. 726 DATED SEPTEMBER 27, 1900.
- THE SUBDIVISIONAL LINES OF TOWNSHIP 14 SOUTH, RANGE 35 EAST WERE SURVEYED BY GEORGE R. CAMPBELL, U.S. DEPUTY SURVEYOR, UNDER CONTRACT NO. 724 DATED SEPTEMBER 27, 1900.
- REMONUMENTATION OF THE QUARTER CORNER BETWEEN SECTIONS 29 AND 30, T.14S., R.35E., BY F.E. CALKINS, PLS #1805, FILED FEBRUARY 11, 1991 IN THE GRANT COUNTY SURVEYOR CORNER RESTORATION RECORDS.
- SURVEY FOR THE MALHEUR NATIONAL FOREST BY LELAND L. MYERS, PLS #699, PERFORMED JULY 15, 1990 TO OCTOBER 28, 1991, UNDER U.S.F.S. CONTRACT NO. 53-D4K-9-02544. MAP OF SURVEY FILED NOVEMBER 30, 1992 IN THE GRANT COUNTY SURVEYOR'S OFFICE AS MAP OF SURVEY NO. 1197. ASSOCIATED LAND CORNER MONUMENTATION RECORDS FOR INDIVIDUAL CORNERS WERE FILED SEPARATELY ON NOVEMBER 30, 1992 IN THE CORNER RESTORATION RECORDS.


FIELD MEASUREMENTS WERE MADE TO RECOVER APPURTENANT CONTROLLING MONUMENTS FROM THE AFOREMENTIONED SURVEYS, WHICH WERE ALL FOUND IN GOOD CONDITION AND ACCEPTED. I ALSO FOUND TWO UNRECORDED IRON PIPES WHICH WERE NOT ACCEPTED, AS SHOWN HEREON.

SECTION 30 WAS SUBDIVIDED WITH REFERENCE TO THE 2009 B.L.M. MANUAL OF SURVEYING INSTRUCTIONS. NEW MONUMENTS WERE SET ACCORDING TO THE EVIDENCE FOUND. AT THE W-E-W 1/256 CORNER, THE CORNER POINT FELL ON THE SOUTH EDGE OF THE RIVERBANK, WHERE A MONUMENT WOULD BE LIABLE TO DESTRUCTION. THEREFORE, TWO REFERENCE MONUMENTS WERE ESTABLISHED, EACH BEING A SAFE DISTANCE FROM THE CORNER.

SEE CORNER MONUMENTATION RECORDS FILED SEPARATELY FOR MORE DETAILS REGARDING THE CORNER EVIDENCE FOUND, NEW MONUMENTS SET, AND CORNER ACCESSORIES ESTABLISHED. THE NATIONAL FOREST BOUNDARIES THAT WERE THE SUBJECT OF THIS SURVEY WERE POSTED WITH ALUMINUM POSTS AND BOUNDARY SIGNS, AS DEPICTED HEREON.

**CORNER MONUMENT MARKINGS**

FOR SUBDIVISION-OF-SECTION CORNERS ESTABLISHED BY THIS SURVEY

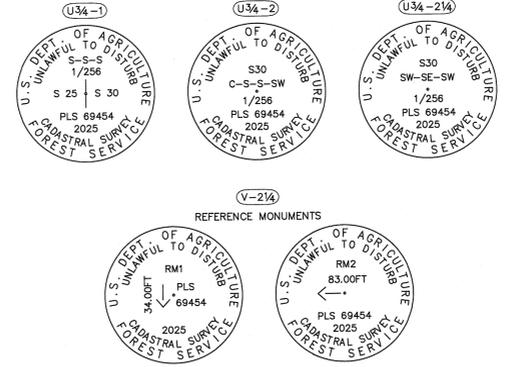

**LEGEND**

- FOUND 2" ALUMINUM PIPE WITH ATTACHED 2 1/2" ALUMINUM CAP MARKED AS SHOWN, SET BY LELAND L. MYERS, PLS #699 SEE MAP OF SURVEY NO. 1187
- ⊙ FOUND 2 1/2" ALUMINUM PIPE WITH ATTACHED 3 1/2" ALUMINUM CAP MARKER AS SHOWN, SET BY F.E. CALKINS, PLS #1805 - SEE RECORD OF LAND CORNER MONUMENTATION FILED FEBRUARY 11, 1991 IN THE GRANT COUNTY SURVEYOR'S OFFICE
- ⊙ SET A 2" X 30" ALUMINUM PIPE WITH ATTACHED 3 1/2" ALUMINUM CAP MARKED AS SHOWN. ALSO SEE CORNER MONUMENTATION RECORDS FILED SEPARATELY FOR MORE DETAILS
- FOUND AN UNRECORDED 2" DIAMETER IRON PIPE WITH THREADED PLUMBING CAP ATTACHED - ORIGIN AND SIGNIFICANCE UNKNOWN, NOT ACCEPTED
- ( ) G.L.O. RECORD BEARING AND DISTANCE
- [ ] RECORD BEARING AND DISTANCE FROM MAP OF SURVEY NO. 1197
- x-x- EXISTING FENCE
- ==== NATIONAL FOREST BOUNDARY POSTED THIS SURVEY WITH ALUMINUM FENCE POSTS WITH USFS PROPERTY BOUNDARY SIGNS ATTACHED
- (A-1) PLS CORNER INDEX DESIGNATION
- NFSL NATIONAL FOREST SYSTEM LAND

**REFERENCES**

- GRANT COUNTY SURVEYOR'S RECORDS: RECORD MAP OF SURVEY NO. 1197 CORNER RESTORATION RECORDS
- GRANT COUNTY DEED RECORDS: DEED BOOK 92 PAGE 194 DEED BOOK 92 PAGE 625 DEED BOOK 93 PAGE 95 DEED NO. 082119
- GENERAL LAND OFFICE RECORDS

I HEREBY CERTIFY THAT THIS SURVEY WAS PERFORMED AT THE REQUEST OF THE MALHEUR NATIONAL FOREST

**ANN NIESEN** Digitally signed by ANN NIESEN  
Date: 2025.08.18 12:19:58 -0700  
FOREST SUPERVISOR DATE

**BASIS OF BEARINGS**

GEODETIC NORTH  
DETERMINED FROM GPS OBSERVATION TAKEN AT THE SOUTH 1/4 CORNER SECTION 30



RECEIVED AND FILED  
GRANT COUNTY SURVEYOR

AUG 25 2025

BY: *[Signature]*



|   |                                      |
|---|--------------------------------------|
| UNITED STATES DEPARTMENT OF AGRICULTURE<br><b>FOREST SERVICE</b><br>REGION 6 - NORTHEAST OREGON LAND ZONE<br>1550 DEWEY AVENUE, SUITE A - BAKER CITY, OREGON 97814 - (541) 523-1283 |                                      |
| MAP OF SURVEY<br>A DEPENDANT RESURVEY AND SUBDIVISION OF SECTION 30,<br>T.14S., R.35E., W.M.,<br>GRANT COUNTY, OREGON   |                                      |
| SURVEYED FOR  | MALHEUR NATIONAL FOREST              |
| SURVEYED BY   | JLH & TJQ SURVEY COMPLETED: 8/5/2025 |
| SCALE: 1" = 400'  | DRAWN BY: JLH & TJQ                  |