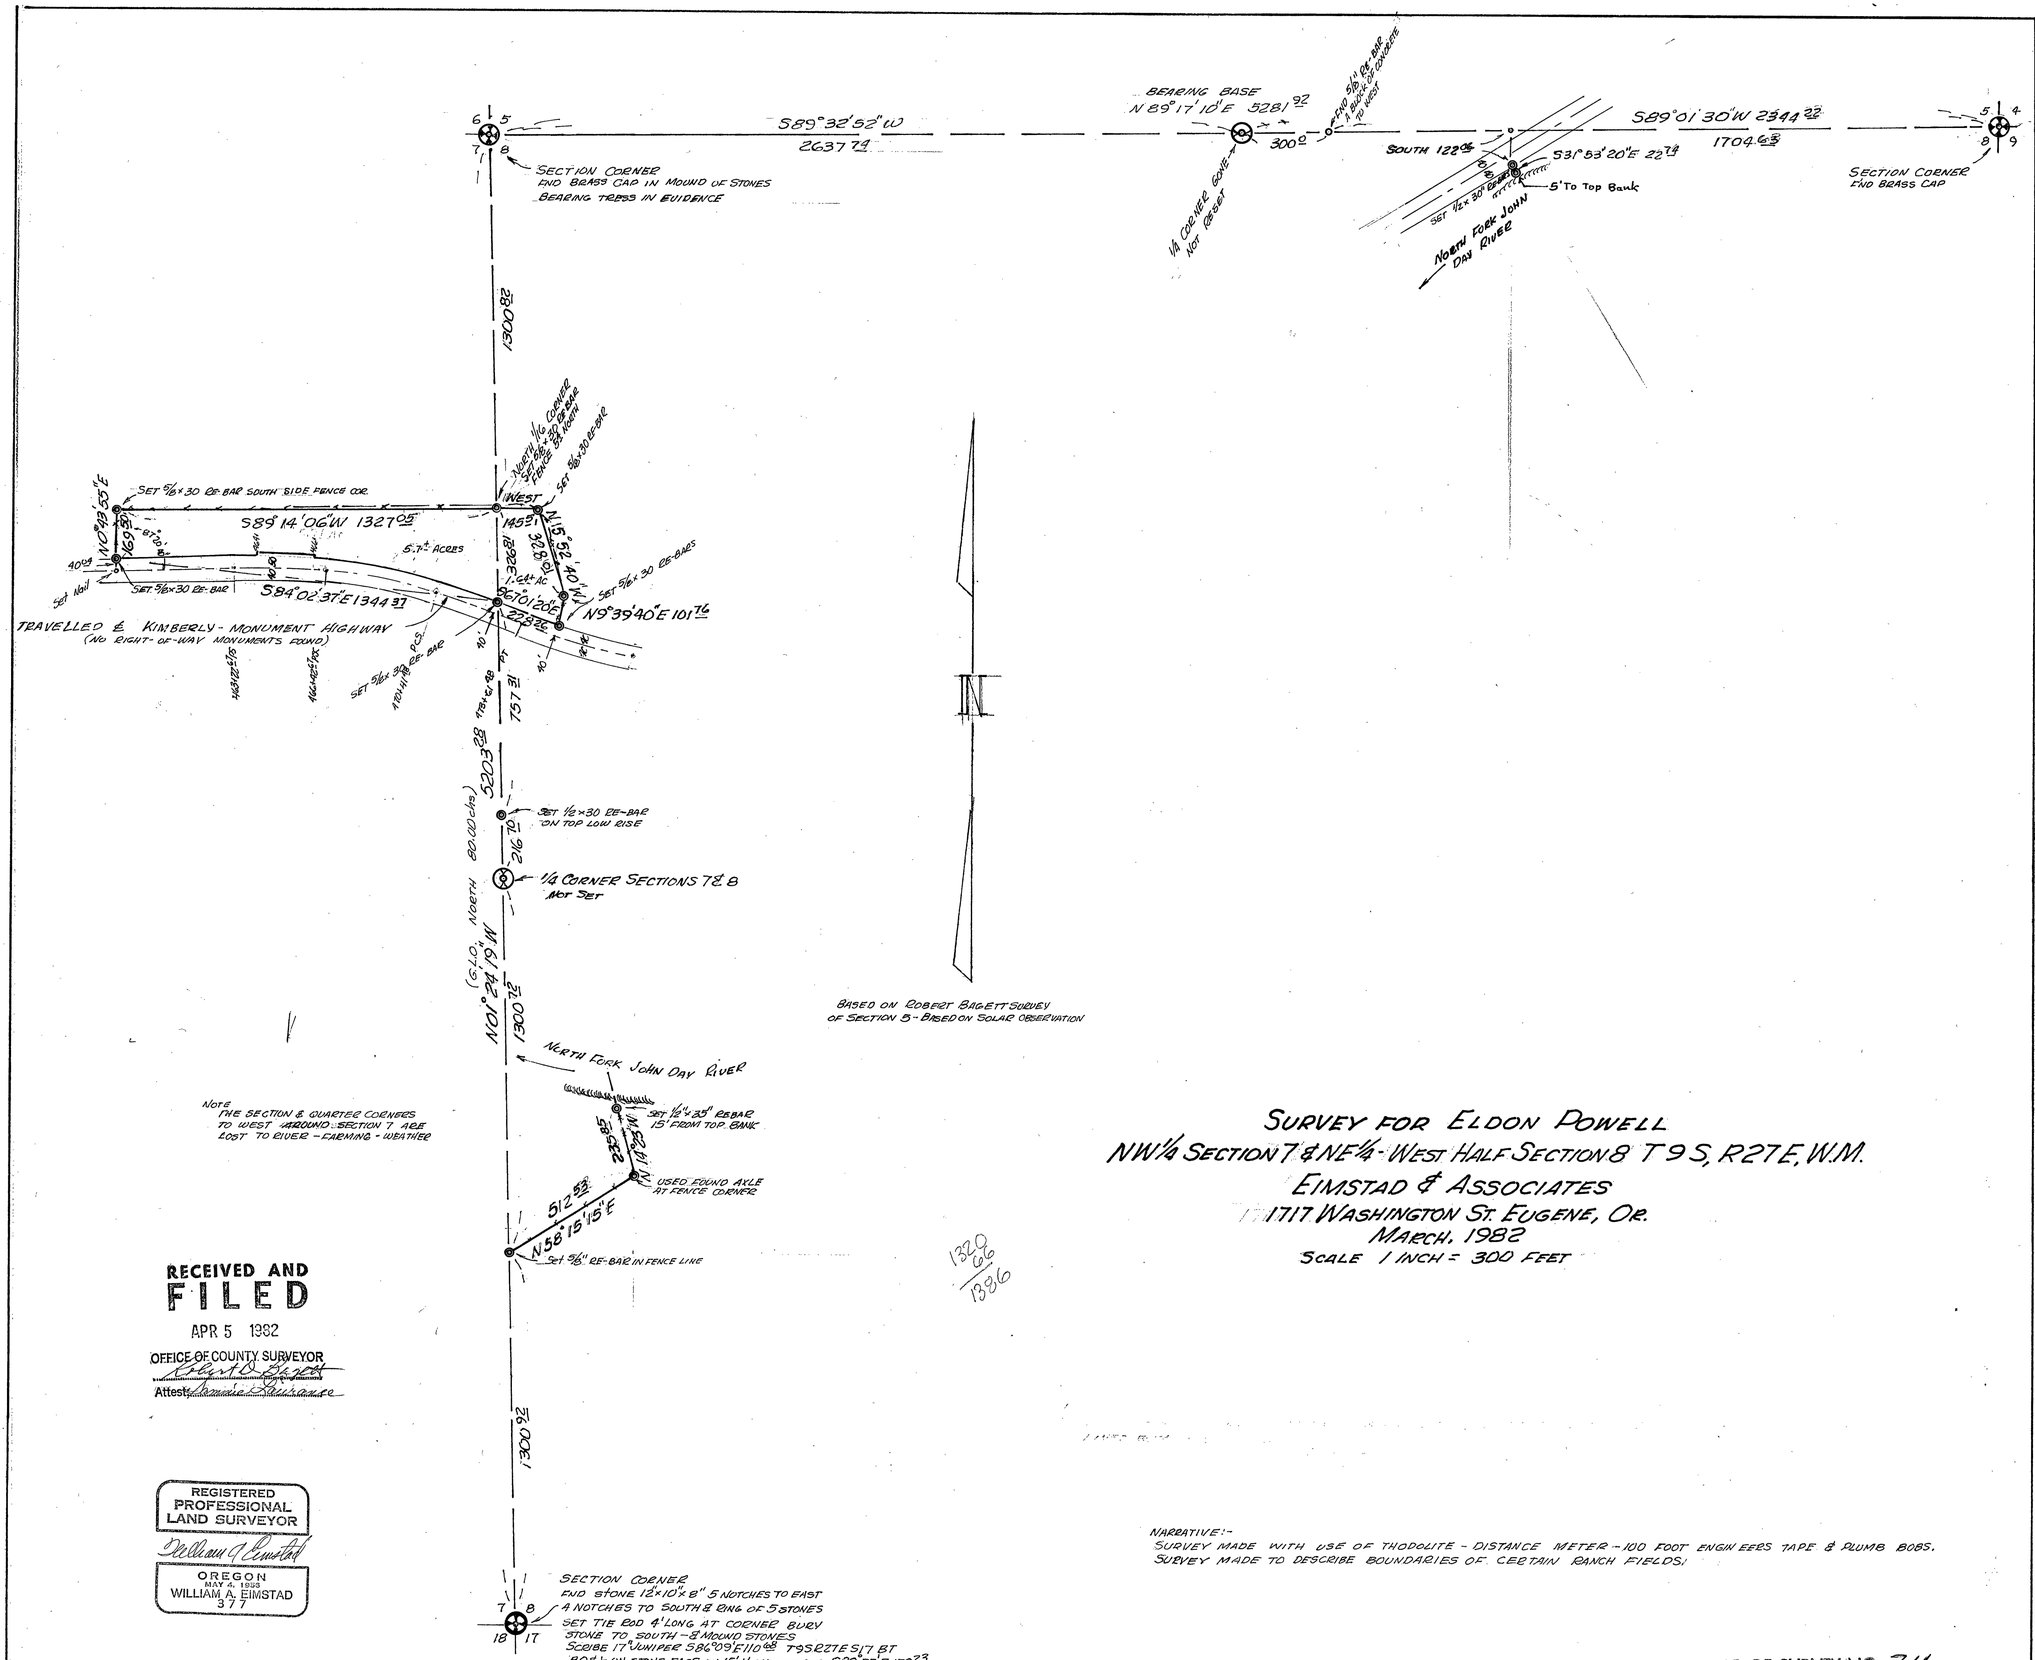

BASED ON ROBERT BAGETT SURVEY
OF SECTION 5 - BASED ON SOLAR OBSERVATION

NOTE
THE SECTION & QUARTER CORNERS
TO WEST AROUND SECTION 7 ARE
LOST TO RIVER - FARMING - WEATHER

RECEIVED AND
FILED
APR 5 1982
OFFICE OF COUNTY SURVEYOR
Robert D. Bagett
Attest: Jeannie Rasmussen

REGISTERED
PROFESSIONAL
LAND SURVEYOR
William A. Eimstad
OREGON
MAY 4, 1965
WILLIAM A. EIMSTAD
377

1320.66
1386

SURVEY FOR ELDON POWELL
NW1/4 SECTION 7 & NE1/4 - WEST HALF SECTION 8 T 9 S, R 27 E, W.M.

EIMSTAD & ASSOCIATES
1717 WASHINGTON ST. EUGENE, OR.

MARCH, 1982
SCALE 1 INCH = 300 FEET

NARRATIVE:-
SURVEY MADE WITH USE OF THODOLITE - DISTANCE METER - 100 FOOT ENGINEERS TAPE & PLUMB BOBS.
SURVEY MADE TO DESCRIBE BOUNDARIES OF CERTAIN RANCH FIELDS.

MAP OF SURVEY NO. 711