
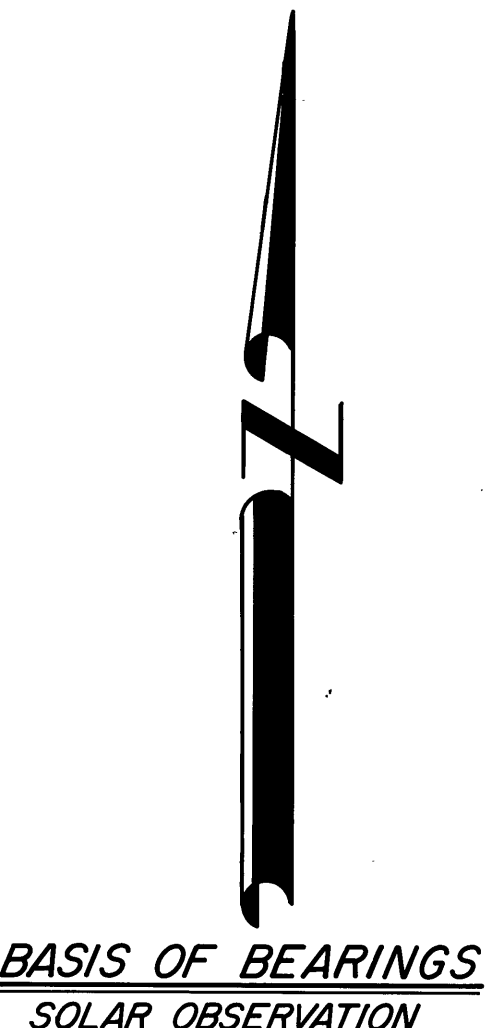


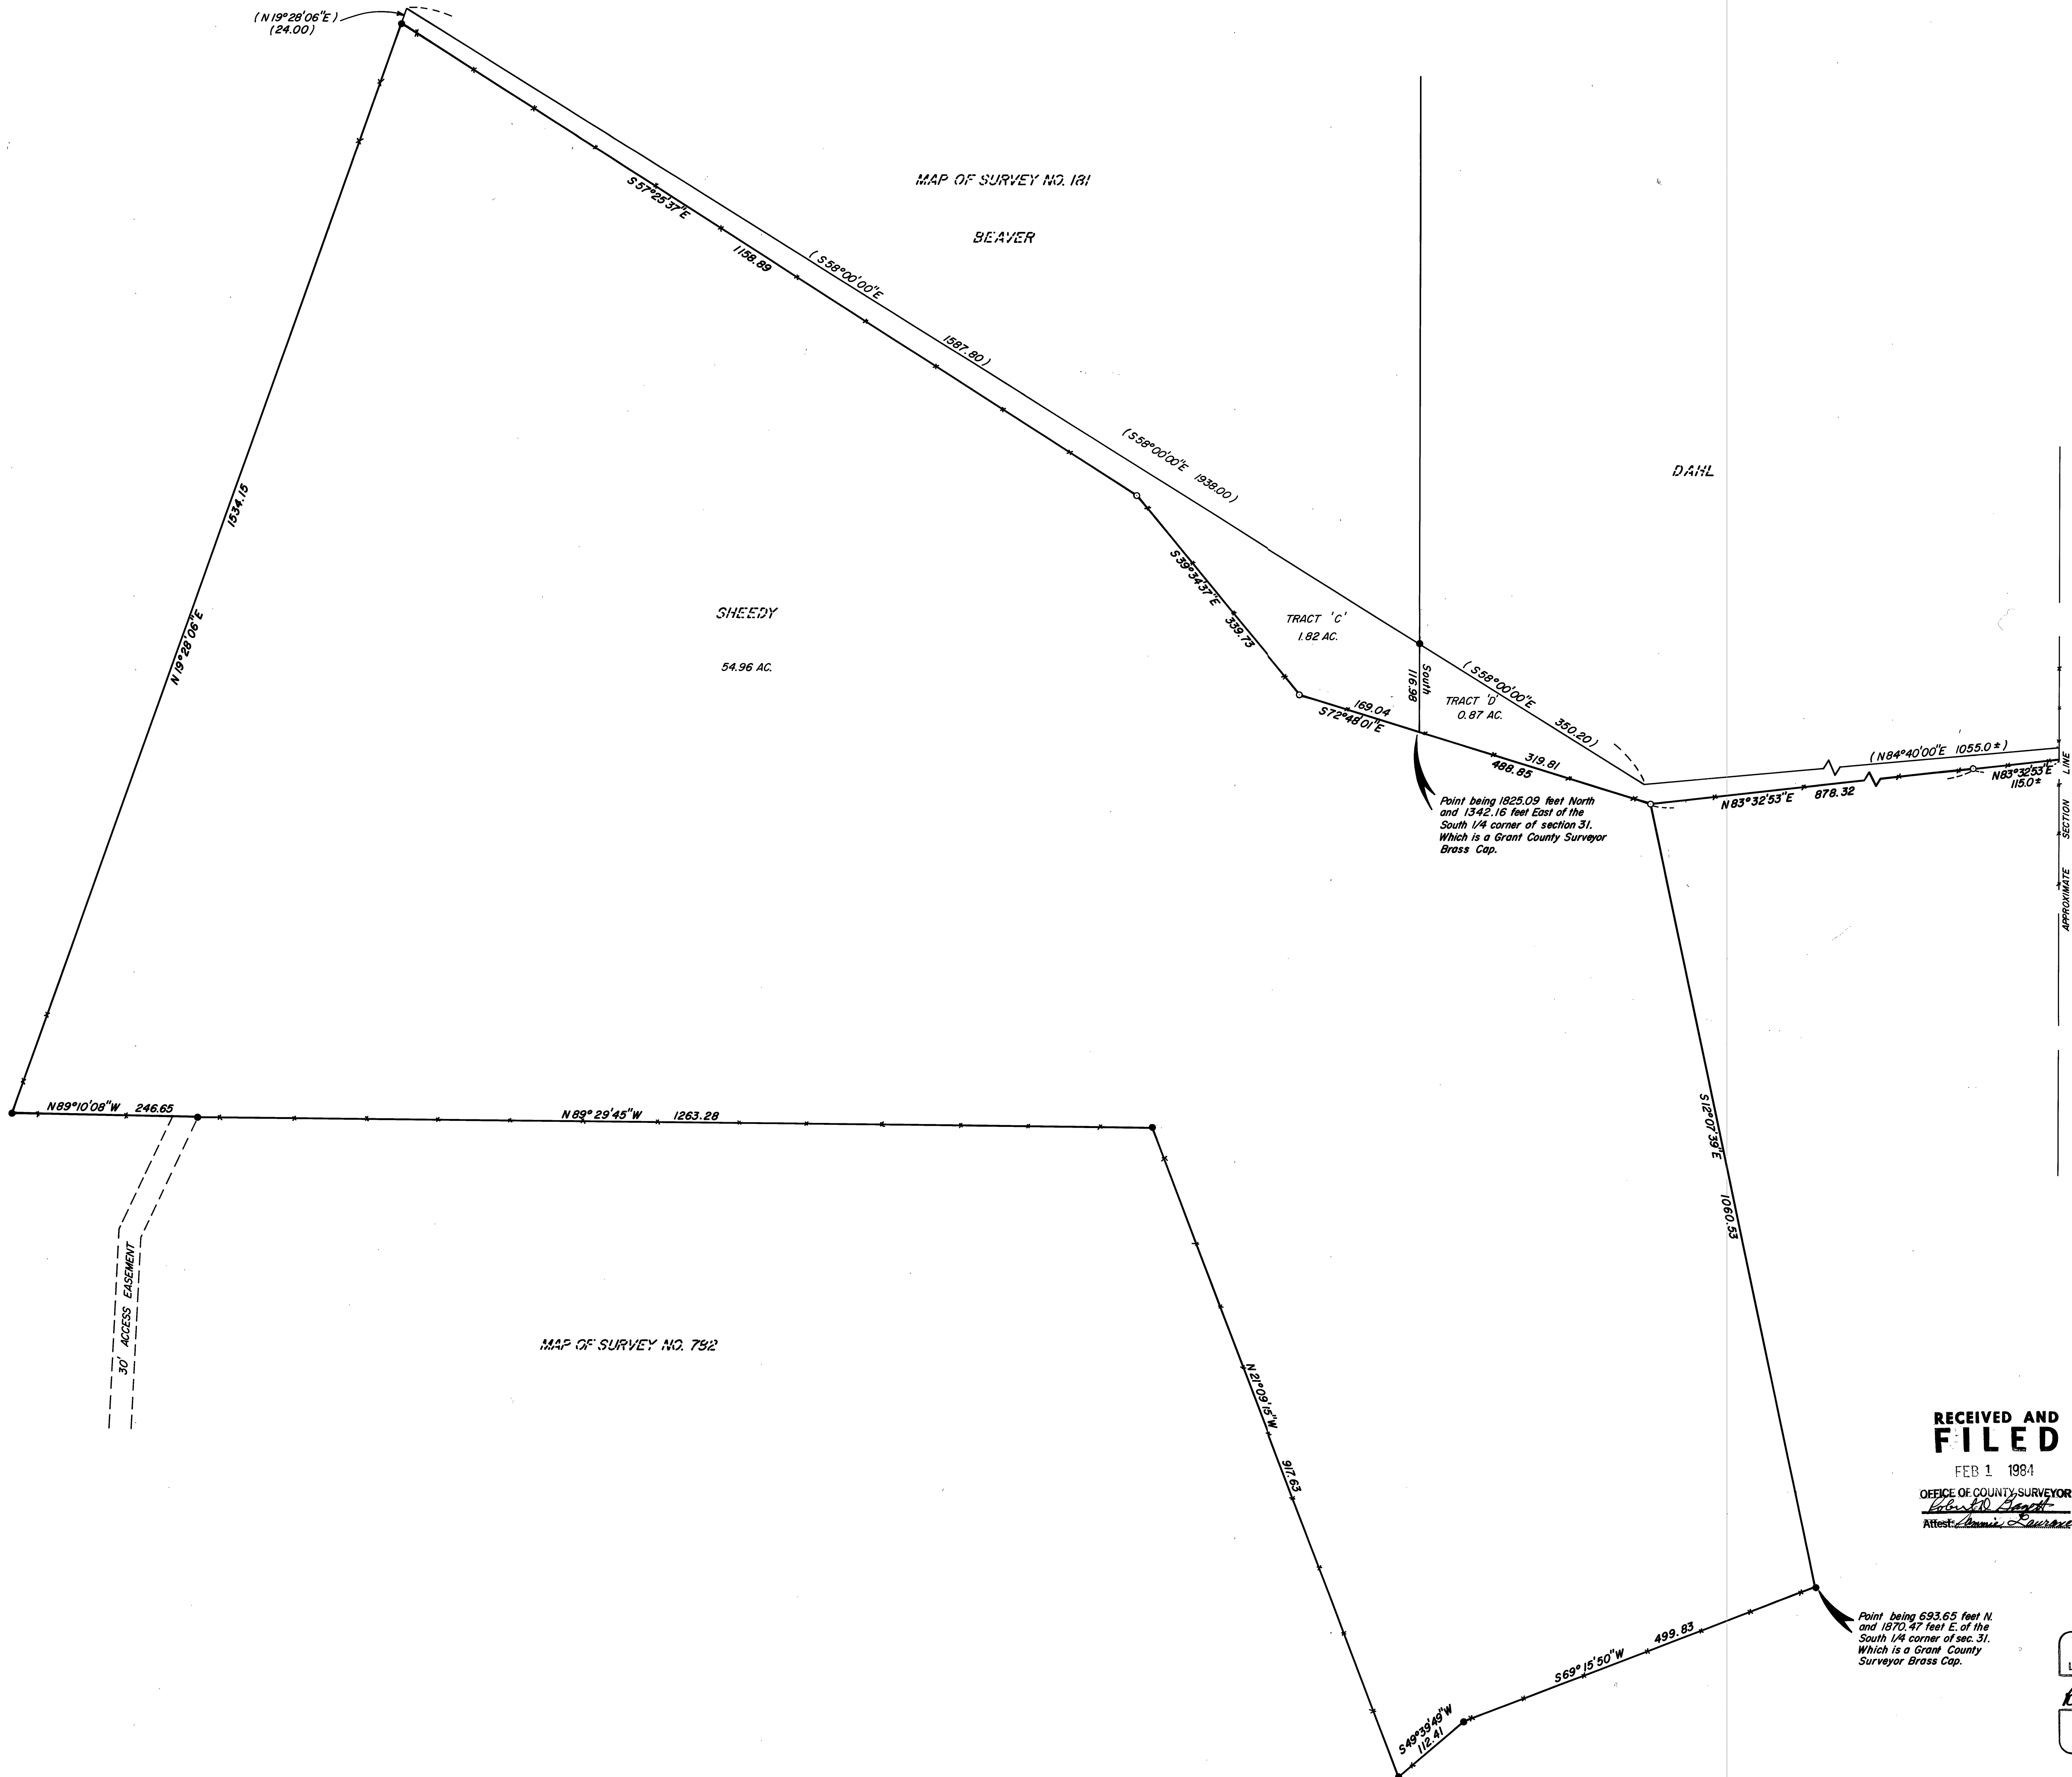

- LEGEND**
- Found 5/8" iron pin of record
 - Set 5/8" x 30" iron pin with attached yellow plastic cap marked B-G-A SURVEY MARKER
 - x— Fence lines
 - () Deed record bearing and distance

REFERENCES

Map of survey no.s	181 & 782
Deed records	Book Page
	107 11
	114 553
	123 429

Narrative: This survey was performed at the request of Carl Sheedy to delineate the tract of land shown hereon. A search was made of the available records pertaining to this survey. Field measurements were made to locate existing monuments. New monuments were set along the North line of this tract as directed by Mr. Sheedy. I found no unusual conditions with this survey.

NOTE: Fence lines shown are generally within a few feet of the surveyed lines.

RECEIVED AND FILED
FEB 1 1984

OFFICE OF COUNTY SURVEYOR
Robert D. Baggett
Attest: *Annexa L. Lawrence*

REGISTERED PROFESSIONAL LAND SURVEYOR
Robert D. Baggett
OREGON
JULY 12, 1983
ROBERT D. BAGGETT
598

BAGETT, GRIFFITH & ASSOCIATES John Day, Oregon Map of Survey		
SITUATED IN SECTION 31, T13S, R32E, W1M.		
GRANT COUNTY, OREGON		
SURVEYED FOR	CARL SHEEDY	
SURVEYED BY	R.D.B. & J.L.W.	1/24/84
Scale: 1" = 100'	Drawn by: J.L.W.	1/26/84