MAP OF SURVEY

Retracing a Portion of Mineral Survey No. 838 & the BLM Subdivision of Section 7 and Subdividing the SW1/4 of Section 7, T12S, R34E, WM

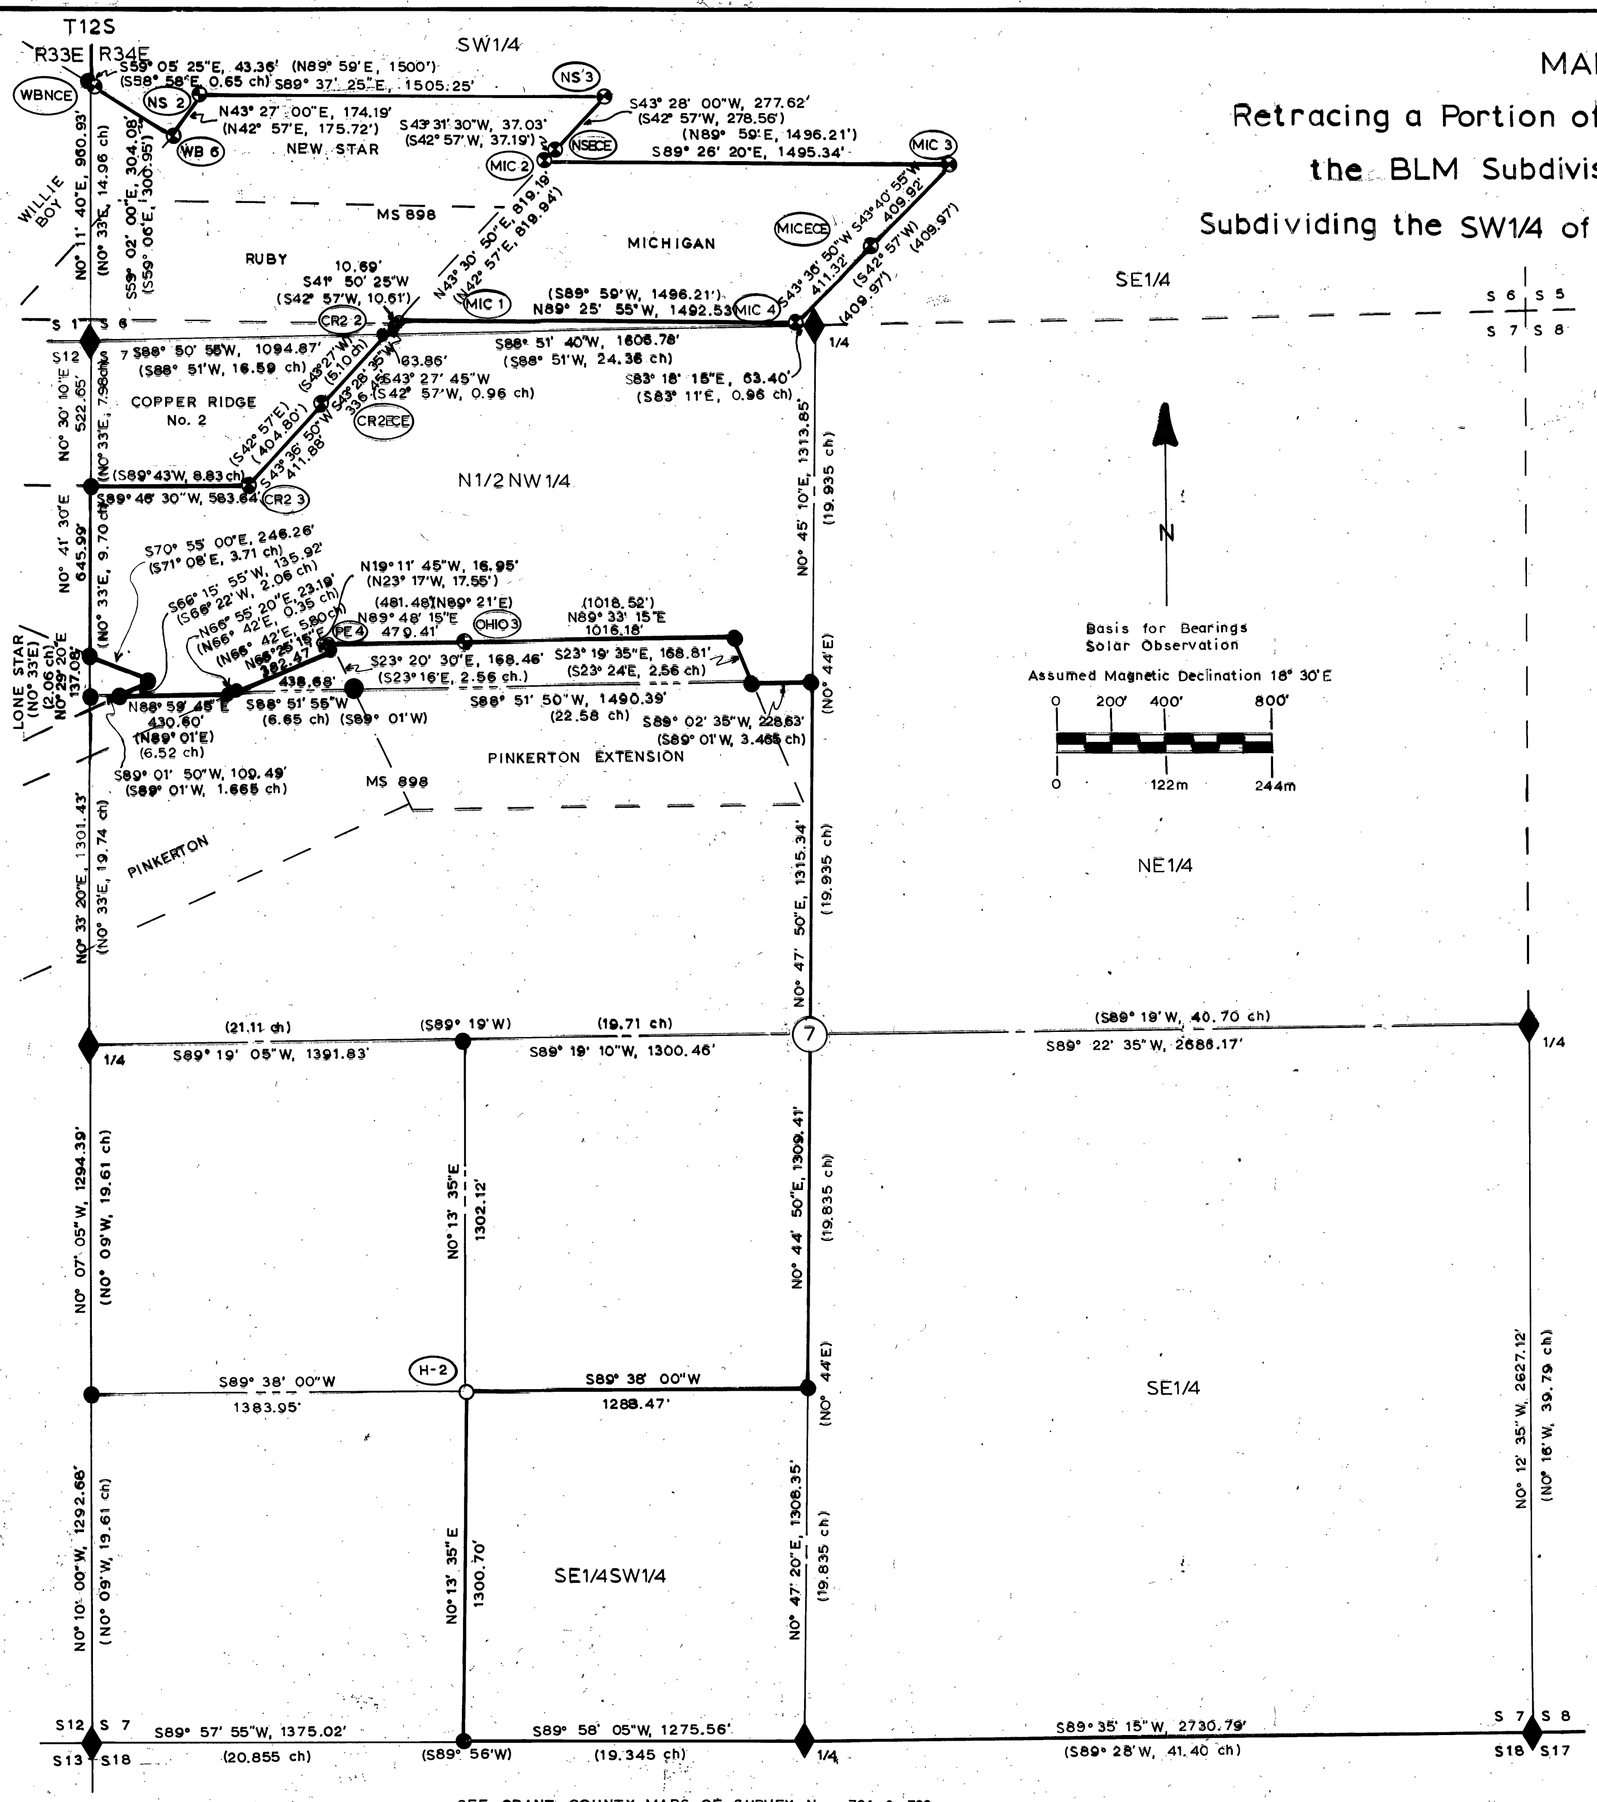

LEGEND

- Section & 1/4 Corners Monumented by BLM 1966-81
- 1/16 and Mineral Survey Corners Set by BLM 1966-81
- C1/4 Set by BLM 1981
  All BLM monuments are 2" Galvanized Pipe with 2 1/2" Brass Cap
- Mineral Survey Set by Found Evidence
- 1/16th Corner Set by Survey
  All monuments set this survey are 2" Aluminum Pipe with 3 1/4" Aluminum Cap
- Posted Property Lines
- Section Lines
- Center Section Lines
- 1/16th Lines
- Projected Lines
- Certified Corner Record Index No. (H-2)
  See Corner Restoration Records
- Legal Subdivision of USFS Property — SE1/4
- Record Bearing & Distance in Parentheses — (21.11 ch)
  See Narrative of Survey for survey history

See separate Narrative of Survey for additional information.

CERTIFICATION

I, Leland Lee Myers, a Professional Land Surveyor in the State of Oregon, at PO Box 98, Sumpter, OR 97877, do hereby certify that I did perform this survey September 12 to November 1, 1985, as a contractor at the request of the USDA-Forest Service by Contract No. 53-04H1-4-9667N and that the information shown hereon is correct to the best of my knowledge.

RECEIVED AND FILED
DEC 16 1985
OFFICE OF COUNTY SURVEYOR
Robert D. Bagett
Asst. Jack L. Watson

REGISTERED PROFESSIONAL LAND SURVEYOR
OREGON
JULY 9, 1970
LELAND LEE MYERS
699

See Map 5

SEE GRANT COUNTY MAPS OF SURVEY Nos. 721 & 722

MAP OF Survey No. 910